

STATE ENGINEER
Salem, Oregon

MULT 002019 Well Record

STATE WELL NO. 2N/1-32K
COUNTY Multnomah
APPLICATION NO. GR-2270

OWNER: Northwest Packing Co.


MAILING ADDRESS: P. O. Box 1856, 440 N. Columbia Blvd.

LOCATION OF WELL: Owner's No.

CITY AND STATE: Portland, Oregon

NW 1/4 SE 1/4 Sec. 32 T. 2 N. S. R. 1 E. W.M.

Bearing and distance from section or subdivision corner 392 feet North of corner property stake and 28 feet East of property line

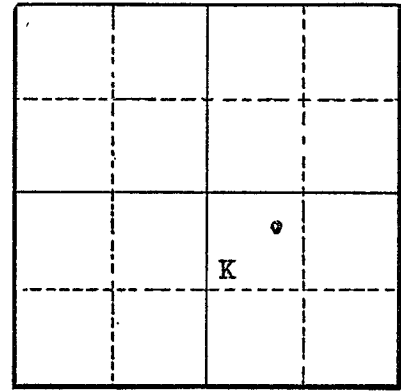

Section 32

Altitude at well

TYPE OF WELL: Drilled Date Constructed 1943

Depth drilled 173 feet Depth cased 173 feet

CASING RECORD:

10-inch casing set from 0 to 173 feet

FINISH:

AQUIFERS:

WATER LEVEL:

PUMPING EQUIPMENT: Type Byron Jackson 1 1/2-7 P35143X H.P.
Capacity G.P.M.

WELL TESTS:
Drawdown 155 ft. after 800 G.P.M.
Drawdown ft. after hours G.P.M.

USE OF WATER Processing water for canning Temp. °F. 19

SOURCE OF INFORMATION GR-4027

DRILLER or DIGGER

ADDITIONAL DATA:
Log (NA) Water Level Measurements Chemical Analysis Aquifer Test

REMARKS: