

STATE ENGINEER  
Salem, Oregon

MULT  
002028

# Well Record

GR- 1542

STATE WELL NO. 2N/1-34N  
COUNTY Multnomah  
APPLICATION NO. GR- 1594

OWNER: Hayden Island Amusement Company

MAILING ADDRESS: Hwy. 99 & Interstate Bridge


LOCATION OF WELL: Owner's No.

CITY AND STATE: Portland 17, Oregon

SW 1/4 SW 1/4 Sec. 34 T. 2 N. R. 1 E. W.M.

Bearing and distance from section or subdivision

corner 1348' N. 12°30' E. from SW cor. Sec. 34

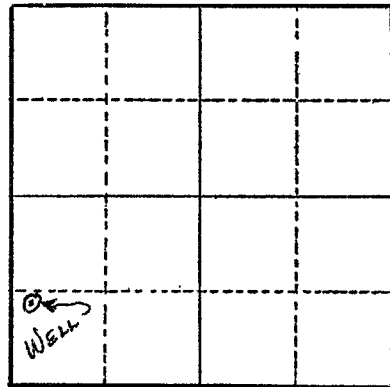

Section 34

Altitude at well 28'

TYPE OF WELL: Drilled Date Constructed 1943

Depth drilled 232' Depth cased 232'

### CASING RECORD:

- 12" from 0 to 190 ft.
- 10" from 181 to 232 ft.

### FINISH:

- Perforated: 200 to 210.5 ft.
- 212 to 220 ft.

### AQUIFERS:

Gravel

### WATER LEVEL:

27'

PUMPING EQUIPMENT: Type M.C. turbine 12" 5 stage H.P. 60  
Capacity 1000 G.P.M.

### WELL TESTS:

Drawdown 34 ft. after \_\_\_\_\_ hours 1000 G.P.M.  
 Drawdown 27 ft. after \_\_\_\_\_ hours 800 G.P.M.

USE OF WATER Industrial & Domestic Temp. °F. 19

SOURCE OF INFORMATION GR Record

DRILLER or DIGGER R. J. Strasser

### ADDITIONAL DATA:

Log \_\_\_\_\_ Water Level Measurements \_\_\_\_\_ Chemical Analysis \_\_\_\_\_ Aquifer Test \_\_\_\_\_

### REMARKS:

Log: Dredge sand & silt with fine sand 0 to 166 ft.  
 Sand gravel with some water 166 to 178 ft.  
 Cemented gravel 178 to 195 ft.  
 Water bearing gravel 195 to 220 ft.  
 Gravel with clay binder 220 to 232 ft.