

STATE ENGINEER  
Salem, Oregon.

# MULT Well Record

STATE WELL NO. 1/3-9B  
COUNTY MULTNOMAH  
~~APPLICATION NO.~~ GR-2760

**002152**

OWNER: Theo Van Doninck


MAILING ADDRESS: 720 West Division Street

LOCATION OF WELL: Owner's No. \_\_\_\_\_

CITY AND STATE: Gresham, Oregon

NW 1/4 NE 1/4 Sec. 9 T. 1 S., R. 3 E., W.M.

Bearing and distance from section or subdivision corner 1310' E. and 150' S.

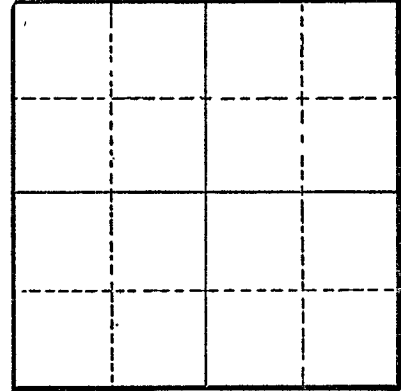

Section \_\_\_\_\_

Altitude at well \_\_\_\_\_

TYPE OF WELL: drilled Date Constructed 1952

Depth drilled 139 Depth cased 139

CASING RECORD:

6-inch

FINISH:

Perforated from 120 to 135

AQUIFERS:

Clay and gravel

WATER LEVEL:

84-feet

PUMPING EQUIPMENT: Type Sumio submersible H.P. 3 1/3

Capacity .25 G.P.M.

WELL TESTS:

Drawdown 50 ft. after \_\_\_\_\_ hours Pumping 20 G.P.M.

Drawdown \_\_\_\_\_ ft. after \_\_\_\_\_ hours \_\_\_\_\_ G.P.M.

USE OF WATER irrigation Temp. \_\_\_\_\_ °F. \_\_\_\_\_, 19\_\_\_\_\_

SOURCE OF INFORMATION GR-2611

DRILLER or DIGGER \_\_\_\_\_

ADDITIONAL DATA:

Log  Water Level Measurements \_\_\_\_\_ Chemical Analysis \_\_\_\_\_ Aquifer Test \_\_\_\_\_

REMARKS:

Clay 40 40  
Cement gravel 99 139