

STATE ENGINEER
Salem, Oregon

MULT Well Record
002153
GR- 1320

STATE WELL NO. 1/3-9H
COUNTY Multnomah
APPLICATION NO. GR- 1251

OWNER: Roger. R. & Laura B. Giles


MAILING ADDRESS: 219 West 1st St.

LOCATION OF WELL: Owner's No. _____

CITY AND STATE: Gresham, Oregon

SE 1/4 NE 1/4 Sec. 9 T. 1 S., R. 3 XX E. XX, W.M.

Bearing and distance from section or subdivision corner 90' W. & 2130' S. from NE cor. Sec. 9

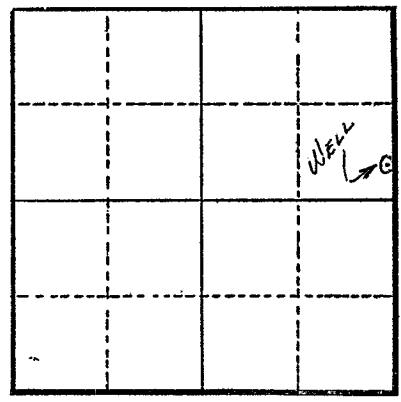

Section 9

Altitude at well 307 ft.

TYPE OF WELL: Dug & Drl Date Constructed 1940

Depth drilled 15 ft. Depth cased 15 ft.

CASING RECORD:

- 16 in. from 0 to 6 ft.
- 14 in. from 6 to 15 ft.

FINISH:

Perforated: 1/4 in. holes every 4 in. from 11 to 15 ft.

AQUIFERS:

WATER LEVEL:

7 ft.

PUMPING EQUIPMENT: Type Jacuzzi Cent. H.P. 1/2

Capacity 12 G.P.M.

WELL TESTS:

Drawdown 0.5 ft. after _____ hours 12 G.P.M.
Drawdown _____ ft. after _____ hours _____ G.P.M.

USE OF WATER Irrigation Temp. _____ °F. _____, 19

SOURCE OF INFORMATION G. R. Record

DRILLER or DIGGER _____

ADDITIONAL DATA:

Log _____ Water Level Measurements _____ Chemical Analysis _____ Aquifer Test _____

REMARKS:

- Log: Clay & hard pan 0 to 7 ft.
- Sand (coarse) 7 to 15 ft.

Irrigation of 2.61 acres.