

STATE ENGINEER
Salem, Oregon

MULT
002154

Well Record


STATE WELL NO. 1/3-90
COUNTY MULTNOMAH
APPLICATION NO. GR-3984

OWNER: R. E. and L. V. Schedeen
MAILING ADDRESS: Gresham

LOCATION OF WELL: Owner's No. _____
CITY AND STATE: Oregon

SW 1/4 SE 1/4 Sec. 1 T. 3 S., R. E., W.M.

Bearing and distance from section or subdivision
corner 1060' N & 200' E from S 1/4 cor Sec 9

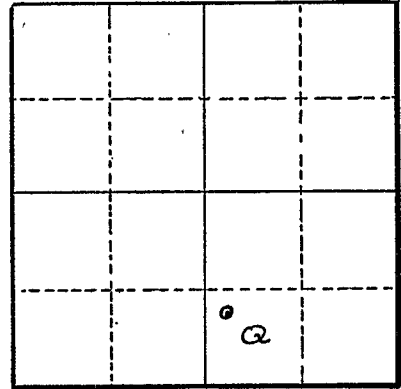

Section 9

Altitude at well _____

TYPE OF WELL: Drilled Date Constructed 1936

Depth drilled 160' Depth cased 160'

CASING RECORD:

8-inch surface to 109'
6-inch 109' to 160'

FINISH:

6-inch liner

AQUIFERS:

WATER LEVEL:

90'

PUMPING EQUIPMENT: Type Pomona Turbine H.P. 7 1/2

Capacity 160 G.P.M.

WELL TESTS:

Drawdown 55 ft. after 150 hours G.P.M.

Drawdown _____ ft. after _____ hours G.P.M.

USE OF WATER Irrigation Temp. _____ °F., 19

SOURCE OF INFORMATION GR-3970

DRILLER or DIGGER _____

ADDITIONAL DATA:

Log NA Water Level Measurements _____ Chemical Analysis _____ Aquifer Test _____

REMARKS: