

STATE ENGINEER  
Salem, Oregon

MULT  
002167

# Well Record

GR- 1551

STATE WELL NO. 1/3-11D  
COUNTY Multnomah  
APPLICATION NO. GR- 1561

OWNER: William Pfaff


MAILING ADDRESS: 823 NE 82nd

LOCATION OF WELL: Owner's No. #1

CITY AND STATE: Portland 20, Oregon

NW 1/4 NW 1/4 Sec. 11 T. 1 S. R. 3 W.M.

Bearing and distance from section or subdivision corner 950' S. & 420' E. from NW cor. Sec. 11

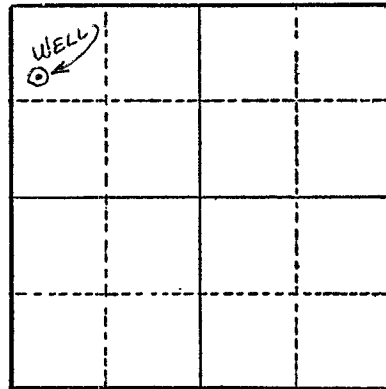

Section 11

Altitude at well

TYPE OF WELL: Drilled Date Constructed 1946

Depth drilled 138' Depth cased 138'

CASING RECORD:  
8"

FINISH:

AQUIFERS:

WATER LEVEL:  
22'

PUMPING EQUIPMENT: Type Cent. H.P. 15  
Capacity 200 G.P.M.

WELL TESTS:  
Drawdown ft. after hours G.P.M.  
Drawdown ft. after hours G.P.M.

USE OF WATER Irrigation Temp. °F. 19

SOURCE OF INFORMATION GR Record

DRILLER or DIGGER G. T. Price

ADDITIONAL DATA:  
Log N.A. Water Level Measurements Chemical Analysis Aquifer Test

REMARKS:

Irrigation of 18 acres.