

STATE ENGINEER
Salem, Oregon

MULT
002168

Well Record

STATE WELL NO. 1/3-11M
COUNTY Multnomah
APPLICATION NO. GR-1844

OWNER: Arthur Suhr NBA Mt. Hood Nursery

MAILING ADDRESS: Rt. 2, Box 96

LOCATION OF WELL: Owner's No. _____

CITY AND STATE: gresham, Oregon


NW 1/4 SW 1/4 Sec. 11 T. 1 N. 1 S., R. 3 E. W.M.

Bearing and distance from section or subdivision corner _____

Altitude at well _____

TYPE OF WELL: Drilled Date Constructed 1938

Depth drilled 128 Depth cased _____

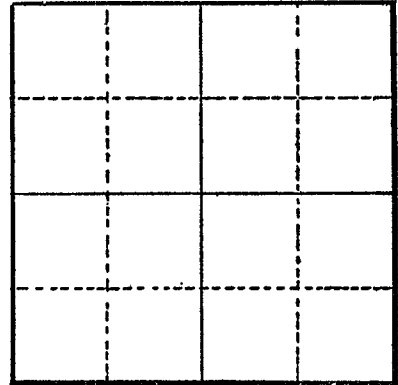

Section 11

CASING RECORD:

FINISH:

AQUIFERS:

WATER LEVEL:

60 feet

PUMPING EQUIPMENT: Type Johnson turbine H.P. 3
Capacity _____ G.P.M.

WELL TESTS:

Drawdown _____ ft. after _____ hours _____ G.P.M.
Drawdown _____ ft. after _____ hours _____ G.P.M.

USE OF WATER Irrigation Temp. _____ °F. _____, 19_____

SOURCE OF INFORMATION GR-1844

DRILLER or DIGGER Haakon Bottner

ADDITIONAL DATA:

Log _____ Water Level Measurements _____ Chemical Analysis _____ Aquifer Test _____

REMARKS: