

STATE ENGINEER  
Salem, Oregon

**MULT Well Record**  
**002174**

STATE WELL NO. 1/3-13E  
COUNTY Multnomah  
APPLICATION NO. GR-2252

OWNER: Warner H. Fahner dba  
White Rose Dairy


MAILING ADDRESS: Route 1

LOCATION OF WELL: Owner's No.

CITY AND STATE: Gresham, Oregon

SW 1/4 NW 1/4 Sec. 13 T. 1 N. S. R. 3 E. W., W.M.

Bearing and distance from section or subdivision  
corner 321 feet East and 360 feet North from W 1/4 Corner,  
Section 13

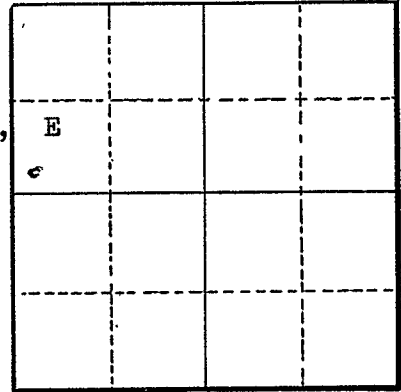

Section 13

Altitude at well \_\_\_\_\_

TYPE OF WELL: Drilled Date Constructed Feb. 1953

Depth drilled 177 feet Depth cased 177 feet

CASING RECORD:

8-inch casing (steel) set from 0 to 177 feet

FINISH:

Perforation from 158 feet to 173 feet

AQUIFERS:

rock, ~~clay~~ and gravel

WATER LEVEL:

81 feet

PUMPING EQUIPMENT: Type Jaccuzzi Turbine H.P. \_\_\_\_\_  
Capacity 225 G.P.M.

WELL TESTS:  
Drawdown 69 ft. after \_\_\_\_\_ hours 220 (8) G.P.M.  
Drawdown 27 ft. after \_\_\_\_\_ hours 100 (1 hr) G.P.M.

USE OF WATER Irrigation & general Temp. 54 °F., 19 \_\_\_\_\_

SOURCE OF INFORMATION GR-4044

DRILLER or DIGGER Haakon I. Bottner Portland, Oregon

ADDITIONAL DATA:  
Log x Water Level Measurements \_\_\_\_\_ Chemical Analysis \_\_\_\_\_ Aquifer Test \_\_\_\_\_

REMARKS:

clay, yellow 1 61  
gravel, cemented 61 65  
rock and clay 65 93  
gravel 93 130  
rock and clay 130 157  
gravel - water bearing 157 177