

STATE ENGINEER
Salem, Oregon

MULT Well Record
002183

STATE WELL NO. 1/3-14F
COUNTY Multnomah
APPLICATION NO. GR-1792

OWNER: Melvin D. Gradin


MAILING ADDRESS: Rt. 2, Box 917

LOCATION OF WELL: Owner's No. #2

CITY AND STATE: Gresham, Oregon

SE 1/4 NW 1/4 Sec. 14 T. 1 S., R. 3 XX, W.M.

Bearing and distance from section or subdivision corner 2000' S. & 1850' E. from NW cor. Sec. 14

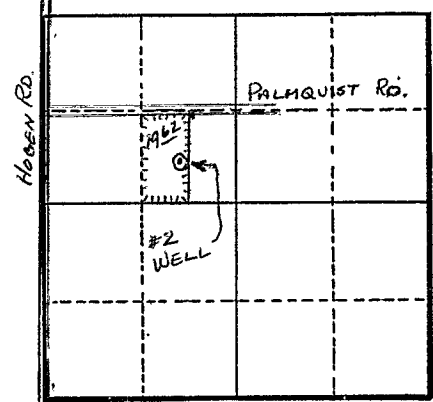

Section 14

Altitude at well 390'

TYPE OF WELL: Drilled Date Constructed 1939

Depth drilled 140' Depth cased 140'

CASING RECORD:
6"

FINISH:
?

AQUIFERS:

WATER LEVEL:
60'

PUMPING EQUIPMENT: Type American-Marsh-Garvens H.P. 3
Capacity 40 G.P.M.

WELL TESTS:
Drawdown 130 ft. after 35 hours G.P.M.
Drawdown ft. after hours G.P.M.

USE OF WATER Irrigation Temp. °F., 19

SOURCE OF INFORMATION GR Record
DRILLER or DIGGER Steinman Bros.

ADDITIONAL DATA:
Log N.A. Water Level Measurements Chemical Analysis Aquifer Test

REMARKS:
Irrigation of 19.62 acres.

WELLS #1 & #2 MANIFOLDED