

STATE ENGINEER
Salem, Oregon

MULT
002185

Well Record

STATE WELL NO. 1/3-14R(1)
COUNTY Multnomah
APPLICATION NO. GR-34

OWNER: James Gordon


MAILING ADDRESS: Rt. 3, Box 460

LOCATION OF WELL: Owner's No.

CITY AND STATE: Gresham, Oregon

SE 1/4 SE 1/4 Sec. 14 T. 1 N S, R. 3 E W, W.M.

Bearing and distance from section or subdivision
corner 55 ft. W. of E. cor. T.I. #26 & 26 ft.
N. from Hillyard Rd.

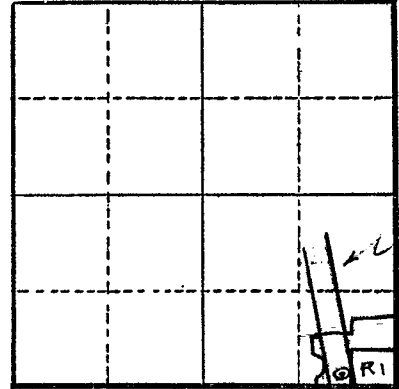

New Hwy
Well Destroyed
Sees G-319B
8-17-66

Altitude at well 450 ft. Interpolated

TYPE OF WELL: drilled Date Constructed Feb., 1953

Depth drilled 197 ft. Depth cased 195 ft.

Section 14

CASING RECORD: 8 inch casing set from 0 to 195 ft.

FINISH: Perforations used between 174 ft. and 192 ft.

AQUIFERS: Gravel from 89 ft. to 125 ft.
Gravel from 130 ft. to 197 ft.

WATER LEVEL: 88 ft. below land surface. Feb. 1953

PUMPING EQUIPMENT: Type Western Land Roller Turbine H.P. 25
Capacity 300 G.P.M.

WELL TESTS:
Drawdown 64 ft. after 250 hours G.P.M.
Drawdown ft. after hours G.P.M.

USE OF WATER irrigation 39 acres Temp. 54 °F., 19

SOURCE OF INFORMATION Registration Statement Gr-34

DRILLER or DIGGER

ADDITIONAL DATA:

Log Water Level Measurements Chemical Analysis Aquifer Test

REMARKS:

