

STATE ENGINEER
Salem, Oregon

MULT
002193

Well Record

STATE WELL NO. 1/3-16D(2)
COUNTY Multnomah
APPLICATION NO. GR-705

OWNER: Yoshio Kinoshita


MAILING ADDRESS: Rt. 1, Box 263

LOCATION OF WELL: Owner's No. 1

CITY AND STATE: Gresham, Oregon

NW 1/4 NW 1/4 Sec. 16 T. 1 N. S. R. 3 W., W.M.

Bearing and distance from section or subdivision
corner 500' E. & 1200' S. from NW cor. Sec. 16

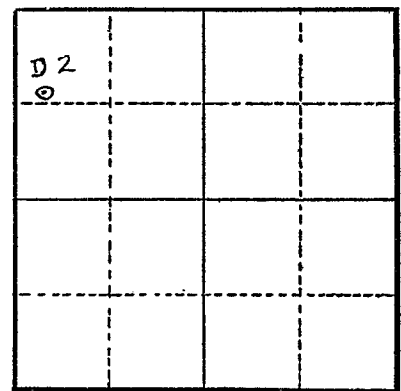

Section 16

Altitude at well 300 ft. Interpolated

TYPE OF WELL: drilled Date Constructed July, 1947

Depth drilled 90 ft. Depth cased 90 ft.

CASING RECORD: 6 inch

FINISH:

AQUIFERS:

WATER LEVEL: 60 ft.

PUMPING EQUIPMENT: Type F. M. Pamona turbine H.P. 3
Capacity 40 G.P.M.

WELL TESTS:
Drawdown 2 ft. after hours 70 G.P.M.
Drawdown ft. after hours G.P.M.

USE OF WATER irrigation Temp. °F. 19

SOURCE OF INFORMATION GR-705

DRILLER or DIGGER Haakon I. Bottner; Portland, Oregon

ADDITIONAL DATA:
Log Water Level Measurements Chemical Analysis Aquifer Test

REMARKS: