

STATE ENGINEER
Salem, Oregon

MULT
002196

Well Record


STATE WELL NO. 1/3-16M
COUNTY MULTNOMAH
APPLICATION NO. GR-2751

OWNER: Magnus Stensrud
MAILING ADDRESS: 1404 N. Killingsworth

LOCATION OF WELL: Owner's No.
CITY AND STATE: Portland, Oregon

NW 1/4 SW 1/4 Sec. 16 T. 1 S. R. 3 E. W.M.

Bearing and distance from section or subdivision
corner S. 62° 00' E.

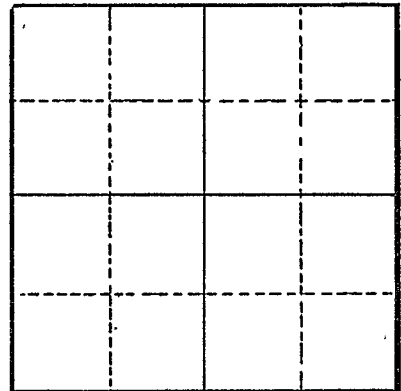

Section

Altitude at well

TYPE OF WELL: drilled Date Constructed 1951

Depth drilled 255 Depth cased 195

CASING RECORD:

8-inch

FINISH:

AQUIFERS:

Clay, boulders, gravel, rock and sand

WATER LEVEL:

170-feet

PUMPING EQUIPMENT: Type Turbine H.P. 7 1/2
Capacity 55 G.P.M.

WELL TESTS:

Drawdown 40 ft. after hours Pumping 60 G.P.M.
Drawdown ft. after hours G.P.M.

USE OF WATER irrigation Temp. °F. 19

SOURCE OF INFORMATION GR-2602

DRILLER or DIGGER

ADDITIONAL DATA:

Log X Water Level Measurements Chemical Analysis Aquifer Test

REMARKS:

Yellow clay 45 45
Yellow clay and boulders 25 70
Cemented gravel 50 120
Broken rock 20 140
cemented gravel 40 180
gravel & brown silty sand with approx. 4 gpm. water 2 180
gravel 13 195
rock some broken 50 245
water bearing lava rock 10