

STATE ENGINEER
Salem, Oregon

MULT Well Record
002226

STATE WELL NO. 1/3-19H
COUNTY Multnomah
APPLICATION NO. GR-3098

OWNER: Hawley H. Kato


MAILING ADDRESS: Route 1, Box 187

LOCATION OF WELL: Owner's No.

CITY AND STATE: Gresham, Oregon

SE 1/4 NE 1/4 Sec. 19 T. 1 N. S. R. 3 E. W. W.M.

Bearing and distance from section or subdivision corner S. 18° 00' W., 1700'

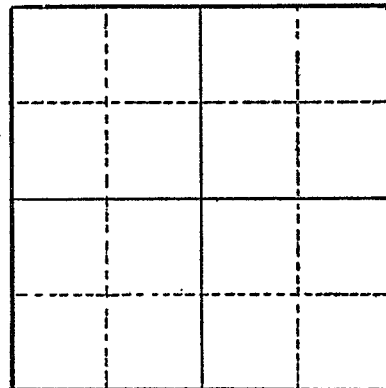

Section

Altitude at well

TYPE OF WELL: Drilled Date Constructed 1953

Depth drilled 350 feet Depth cased 298 feet

CASING RECORD:

10-inch

FINISH:

240 from 110 to 120 192 from 232 to 240
192 from 167 to 175 192 from 276 to 284

AQUIFERS:

Top soil, clay, gravel, sand, shale

WATER LEVEL:

90 feet

PUMPING EQUIPMENT: Type Western Land Roller Turbin Oil Luba H.P. 60
Capacity 360 G.P.M.

WELL TESTS:

Drawdown 85 ft. after hours Pumping 375 G.P.M.
Drawdown 120 ft. after hours Pumping 500 G.P.M.

USE OF WATER Irrigation Temp. °F., 19

SOURCE OF INFORMATION GR-2906

DRILLER or DIGGER

ADDITIONAL DATA:

Log Water Level Measurements Chemical Analysis Aquifer Test

REMARKS:

