

STATE ENGINEER
Salem, Oregon

MULT Well Record
002268 GR- 1722


STATE WELL NO. 1/3-19N
COUNTY Multnomah
APPLICATION NO. GR- 1778

OWNER: Kenneth R. & Elna S. Humke MAILING ADDRESS: 8022 SE 162nd Ave.

LOCATION OF WELL: Owner's No. _____ CITY AND STATE: Portland 36, Oregon

SW 1/4 SW 1/4 Sec. 19 T. 1 S., R. 3 W, W.M.

Bearing and distance from section or subdivision corner 1293.04' N. & 32' E. from SW cor. Sec. 19

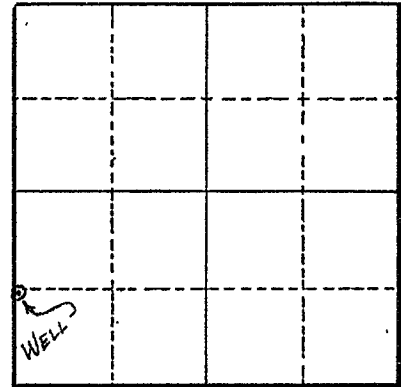

Section 19

Altitude at well 290'

TYPE OF WELL: Drilled Date Constructed 1951

Depth drilled 263' Depth cased 261'

CASING RECORD:
8"

FINISH:
Perforated from 241 to 261 ft.

AQUIFERS:

WATER LEVEL:
80'

PUMPING EQUIPMENT: Type Worthington H.P. 20
Capacity 200 G.P.M.

WELL TESTS:
Drawdown 150 ft. after Nov. 1951 hours 200 G.P.M.
Drawdown _____ ft. after _____ hours _____ G.P.M.

USE OF WATER Irrigation Temp. _____ °F. _____, 19

SOURCE OF INFORMATION GR Record

DRILLER or DIGGER R.E. Frost

ADDITIONAL DATA:
Log N.A. Water Level Measurements _____ Chemical Analysis _____ Aquifer Test _____

REMARKS:
Irrigation of 4.5 acres.