


MULT 2301

STATE ENGINEER
Salem, Oregon

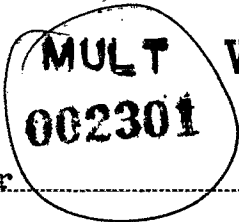

Well Record

STATE WELL NO. 1/3-20E(1)
COUNTY Multnomah
APPLICATION NO. GR-915

GR- 889

OWNER: Fred J. Baker

MAILING ADDRESS: 16919 Foster Rd.


LOCATION OF WELL: Owner's No.

CITY AND STATE: Portland 66, Oregon

SW 1/4 NW 1/4 Sec. 20 T. 1 S, R. 3 W., W.M.

Bearing and distance from section or subdivision

corner 2050' S. & 1300' E. from NW cor. Sec. 20.

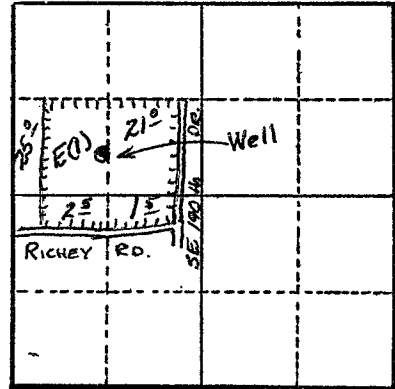

Section 20

Altitude at well 400 ft.

TYPE OF WELL: Drilled Date Constructed 1953

Depth drilled 300 ft. Depth cased 300 ft.

CASING RECORD:

- 10 inch from 0 to 250 ft.
- 8 inch from 250 to 300 ft.

FINISH:

- Perforated: 5 holes per foot 3/16 x 3 in. from 100 to 235 ft.
- 2 holes per foot 3/16 x 3 in. from 250 to 300 ft.

AQUIFERS:

WATER LEVEL:

65 ft.

PUMPING EQUIPMENT: Type Sterling Turbine H.P. 25

Capacity 300 G.P.M.

WELL TESTS:

Drawdown	25	ft. after	hours	300	G.P.M.
Drawdown	60	ft. after	hours	400	G.P.M.

USE OF WATER Irrigation Temp. °F. 19

SOURCE OF INFORMATION GR Record

DRILLER or DIGGER A.O. Olson

ADDITIONAL DATA:

Log Water Level Measurements Chemical Analysis Aquifer Test

REMARKS:

- Log: Clay 0 to 60 ft.
- Cemented gravel 60 to 100 ft.
- Cemented gravel with water 100 to 235 ft.
- Blue clay & gravel 235 to 280 ft.
- Water bearing gravel 280 to 300 ft.

Irrigation of 50 acres.

STATE ENGINEER
Salem, Oregon


MULT 2301
Well Record
MULT 002301

STATE WELL NO. 1/3-20E
COUNTY Multnomah
APPLICATION NO. GR-915

OWNER: Fred J. Baker
MAILING ADDRESS: 16919 S.E. Foster Rd.

LOCATION OF WELL: Owner's No. _____
CITY AND STATE: Portland 66, Oregon

SW 1/4 NW 1/4 Sec. 20 T. 1 N. S., R. 3 E. W.M.
Bearing and distance from section or subdivision
corner 2050' S. & 1300' E. from NW cor. Sec. 20

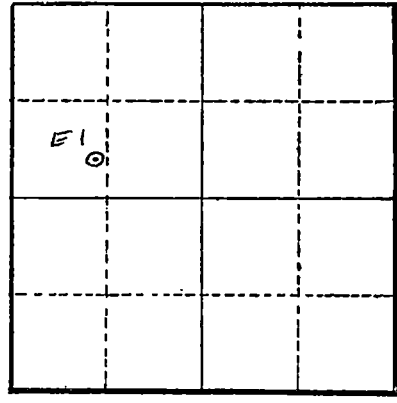

Section 20

Altitude at well 400

TYPE OF WELL: drilled Date Constructed Feb. 1953
Depth drilled 300 Depth cased 300

CASING RECORD: 10 In. dia. 0 ft. - 250 ft.
8 in. dia. 250 ft. - 300 ft.

FINISH: Per. 8, 5 holes per foot 3/16" x 3" 100 ft. - 235 ft.
2 holes per foot 3/16" x 3" 235 ft. - 300 ft.

AQUIFERS: Cemented gravel with water 100 ft. - 235 ft.
Gravel with water 235 ft. - 300 ft.

WATER LEVEL: 65 ft.

PUMPING EQUIPMENT: Type Sterling turbine H.P. 25 elec. G.E.
Capacity 300 G.P.M.

WELL TESTS:
Drawdown 25 ft. after _____ hours 300 G.P.M.
Drawdown 60 ft. after _____ hours 400 G.P.M.

USE OF WATER irrigation Temp. _____ °F. _____, 19

SOURCE OF INFORMATION owner
DRILLER or DIGGER A. O. Olson, Rt. 1, Box 565, Gresham, Ore.

ADDITIONAL DATA:
Log Water Level Measurements _____ Chemical Analysis _____ Aquifer Test _____

REMARKS:

FOLDING INSTRUCTIONS

To fit No. 771 DU-O-VUE envelopes - fold along bottom of shaded strip.
To fit regular No. 10 window envelopes - fold along top of shaded strip.

FORM 107 - 1 • NEW ENGLAND BUSINESS SERVICE, INC. TOWNSEND, MASS.

36-52 - 1420' of 2" 30' ul
1.8 5/16" ~~NOV 1977~~

A. O. OLSEN WELL DRILLING, INC.

18211 S. E. Powell
GRESHAM, OREGON 97030

No. 0251

665-3353

TO

Fred Baker Well
190th & Riekey Rd,
Pleasant Valley,

DATE	Sept. 18-1977
CUSTOMER ORDER NO.	
SALESMAN	
VIA	

TERMS:

Well log Sect 20-T15-N3E Twp 10N R
Drilled - 1953 mult. C

QUANTITY	DESCRIPTION	PRICE	AMOUNT
	10" hole cased to 250'		
	8" liner from 235'-300'		
	Top soil - 0-2'		
	red clay		
	coarse gravel 2-60'		
	80-150'		
	Cement gravel water bearing	150'-235'	
	blue clay & gravel	235'-280'	
	water bearing gravel -	280'-300'	
	well pump tested at 400 gal. per min. with 60' drawdown.		

633 2666

ORIGINAL

Thank You!

A. O. Olson