

STATE ENGINEER
Salem, Oregon

MULT
Well Record
002334

STATE WELL NO. 1/3-22J(1)
COUNTY Multnomah
APPLICATION NO. GR-76

OWNER: Ray and Tom Shiki


MAILING ADDRESS:

LOCATION OF WELL: Owner's No. 1

CITY AND STATE: Gresham, Oregon

NE 1/4 SE 1/4 Sec. 22 T. 1 S. R. 3 W, W.M.

Bearing and distance from section or subdivision
corner 2000' N. & 700' W. from SE cor. Sec. 22

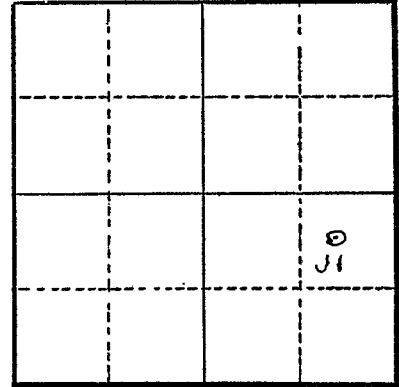

Altitude at well 600 ft. Interpolated

Section 22

TYPE OF WELL: drilled Date Constructed Feb. 1954

Depth drilled 510 ft. Depth cased 342 ft.

CASING RECORD: 12 inch casing set from 0 to 342 ft.

FINISH: Perforations set 265 ft. to 270 ft. and from 332 to 338 ft.

AQUIFERS: Gravel from 265 ft. to 270 ft. and from 331 to 341 ft.

WATER LEVEL: 200 ft. below land surface - 3/29/54

PUMPING EQUIPMENT: Type Western Land Roller - turbine H.P. 75
Capacity 600 G.P.M.

WELL TESTS:
Drawdown 47 ft. after 250 hours G.P.M.
Drawdown 75 ft. after 600 hours G.P.M.

USE OF WATER Irrigation 100 acres Temp. °F. 19

SOURCE OF INFORMATION Registration Statement GR-76

DRILLER or DIGGER

ADDITIONAL DATA:
Log X Water Level Measurements Chemical Analysis Aquifer Test

REMARKS:

