

STATE ENGINEER
Salem, Oregon

MULT Well Record
002382

STATE WELL NO. 1/3-23L
COUNTY Multnomah
APPLICATION NO. GR-2060

OWNER: Frank Wills

MAILING
ADDRESS:

Rt. 3, Box 379A

LOCATION OF WELL: Owner's No.

CITY AND
STATE:

Gresham, Oregon

NE 1/4 SW 1/4 Sec. 23 T. 1 S., R. 3 W., W.M.


Bearing and distance from section or subdivision

corner

Altitude at well

TYPE OF WELL: Drilled Date Constructed 1951

Depth drilled 140 Depth cased

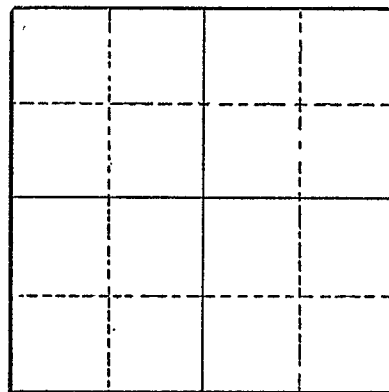

Section 23

CASING RECORD:

Unknown

FINISH:

Unknown

AQUIFERS:

Unknown

WATER LEVEL:

90 feet

PUMPING EQUIPMENT: Type Berkely Line Shaft Turbine 3" H.P. 5
Capacity 60 G.P.M. Electric

WELL TESTS:

Drawdown ft. after hours G.P.M.

Drawdown ft. after hours G.P.M.

USE OF WATER Irrigation Temp. °F. 19

SOURCE OF INFORMATION GR-2060

DRILLER or DIGGER C. E. Hamblet

ADDITIONAL DATA:

Log Water Level Measurements Chemical Analysis Aquifer Test

REMARKS: