

STATE ENGINEER
Salem, Oregon

MULT Well Record
002383

STATE WELL NO. 1/3-23J
COUNTY MULTNOMAH
APPLICATION NO. GR-2963

OWNER: Pat Vessello

MAILING ADDRESS: Rt. 2, Box 941


LOCATION OF WELL: Owner's No.

CITY AND STATE: Gresham, Oregon

NE 1/4 SE 1/4 Sec. 23 T. 1 N. S. R. 3 E. W., W.M.

Bearing and distance from section or subdivision

corner N. 90° 00' W. 1700'

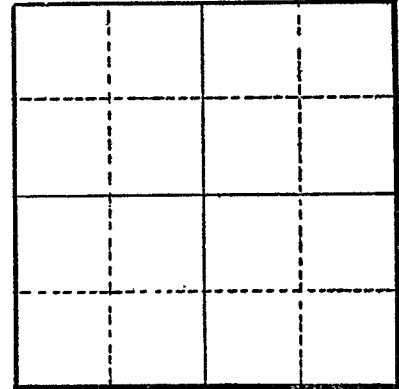

Section

Altitude at well

TYPE OF WELL: drilled Date Constructed 1952

Depth drilled 98 Depth cased 98

CASING RECORD:

6-inch

FINISH:

1" perforations for 20' from 70 to 98

AQUIFERS:

WATER LEVEL:

10-feet

PUMPING EQUIPMENT: Type jacuzzi H.P. 3
Capacity 50 G.P.M.

WELL TESTS:

Drawdown 30 ft. after hours Pumping 100 G.P.M.
Drawdown ft. after hours G.P.M.

USE OF WATER irrigation Temp. °F., 19

SOURCE OF INFORMATION GR-2780

DRILLER or DIGGER O. A. Olson, Rt. 1, Box 565, Gresham, Oregon

ADDITIONAL DATA:

Log Water Level Measurements Chemical Analysis Aquifer Test

REMARKS: