

STATE ENGINEER
Salem, Oregon

MULT
002412

Well Record

STATE WELL NO. 1/3-24E
COUNTY Multnomah
APPLICATION NO. GR-3688

OWNER: Don G. Wallenstein

MAILING

ADDRESS: Route 3, Box 527

CITY AND


STATE: Gresham, Oregon

LOCATION OF WELL: Owner's No. _____

SW $\frac{1}{4}$ NW $\frac{1}{4}$ Sec. 24 T. 1 S., R. 3 W., W.M.

Bearing and distance from section or subdivision

corner Approx. 1970' SE of Sec. cor. 14 - 13 - 23 - 24

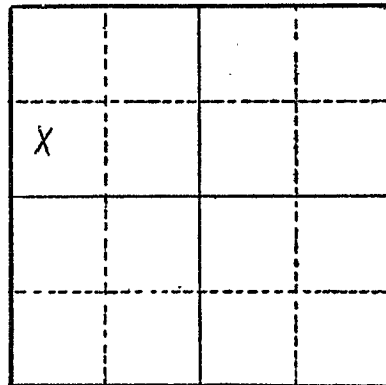

Altitude at well _____

TYPE OF WELL: Drilled Date Constructed 6/25/53

Depth drilled 153 feet Depth cased 153 feet

Section 24

CASING RECORD:

6 inch casing set to 153 feet

FINISH:

AQUIFERS:

WATER LEVEL:

PUMPING EQUIPMENT: Type Jacuzzi Model 5T-4H-120 H.P. 5
Capacity 30 G.P.M.

WELL TESTS:

Drawdown _____ ft. after _____ hours _____ G.P.M.

Drawdown _____ ft. after _____ hours _____ G.P.M.

USE OF WATER Irrigation Temp. _____ °F. _____, 19 _____

SOURCE OF INFORMATION Well Registration Statement

DRILLER or DIGGER A. O. Olsen

ADDITIONAL DATA:

Log _____ Water Level Measurements _____ Chemical Analysis _____ Aquifer Test _____

REMARKS: