

STATE ENGINEER
Salem, Oregon

MULT

Well Record

STATE WELL NO. 1/4-4C
COUNTY Clackamas
APPLICATION NO. GR-3096

OWNER: Kenneth A. Hedden

MAILING

ADDRESS: Route 1, Box 435

LOCATION OF WELL: Owner's No.


CITY AND

STATE: Boring, Oregon

NE 1/4 NW 1/4 Sec. 4 T. 1 S., R. 4 W., W.M.

Bearing and distance from section or subdivision

corner S. 38° 00' W., 180 feet

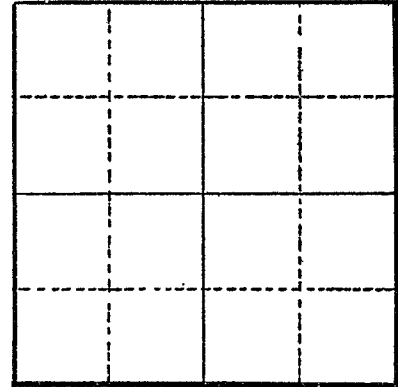

Section

Altitude at well

TYPE OF WELL: Drilled Date Constructed 1947

Depth drilled 118 feet Depth cased 118 feet

CASING RECORD:

6-inch

FINISH:

AQUIFERS:

WATER LEVEL:

20 feet

PUMPING EQUIPMENT: Type Myers jet

H.P. 1

Capacity 7 G.P.M.

WELL TESTS:

Drawdown ft. after hours G.P.M.

Drawdown ft. after hours G.P.M.

USE OF WATER Irrigation

Temp. °F. 19

SOURCE OF INFORMATION GR-2904

DRILLER or DIGGER Haakon I. Bottner

ADDITIONAL DATA:

Log Water Level Measurements Chemical Analysis Aquifer Test

REMARKS: