

STATE ENGINEER
Salem, Oregon

MULT Well Record

STATE WELL NO. 1/4-4N(1)
COUNTY Multnomah
APPLICATION NO. GR-432

OWNER: Elmer Larson

MAILING

ADDRESS: Rt. 1, Box 142

LOCATION OF WELL: Owner's No. 002441

CITY AND

STATE: Troutdale, Oregon

SW $\frac{1}{4}$ SW $\frac{1}{4}$ Sec. 4 T. 1 ~~N~~ E, R. 4 ~~W~~, W.M.

Bearing and distance from section or subdivision


corner 1250' E. of the SW cor. Sec. 4

Altitude at well 310

TYPE OF WELL: drilled Date Constructed 10/7/53

Depth drilled 150 Depth cased 150

CASING RECORD: 8 inch to 90 ft.
6 inch from 90 to 150 ft.

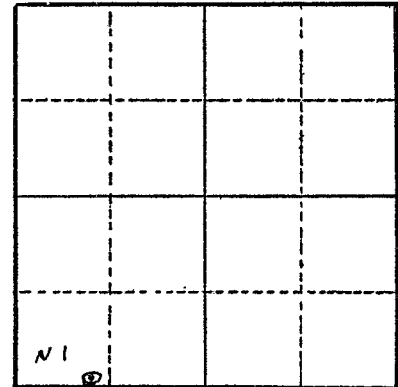

Section 4

FINISH:

AQUIFERS:

WATER LEVEL: 90 ft.

PUMPING EQUIPMENT: Type Jacuzzi turbine H.P. 7 $\frac{1}{2}$
Capacity 80 G.P.M.

WELL TESTS:
Drawdown 10 ft. after 75 hours 75 G.P.M.
Drawdown 15 ft. after 90 hours 90 G.P.M.

USE OF WATER irrigation 20 ac. Temp. °F., 19

SOURCE OF INFORMATION GR-432

DRILLER or DIGGER O. B. Olsen

ADDITIONAL DATA:

Log X Water Level Measurements Chemical Analysis Aquifer Test

REMARKS:

STATE ENGINEER
Salem, Oregon

State Well No. 1/4-4N(1)
County Multnomah
Application No. GR-432

Well Log

Owner: Elmer Larson Owner's No. _____

Driller: O. B. Olsen Date Drilled Oct. 7, 1953

[illegible]