

STATE ENGINEER
Salem, Oregon

MULT
002447

Well Record

STATE WELL NO. 1/4-5M
COUNTY Multnomah
APPLICATION NO. GR-3400

OWNER: Percy O. Carlson


MAILING ADDRESS: Route 2, Box 1003

LOCATION OF WELL: Owner's No.

CITY AND STATE: Troutdale, Oregon

NW 1/4 SW 1/4 Sec. 5 T. 1 N. S. R. 1 E. W.M.

Bearing and distance from section or subdivision corner S. 31°30' E.

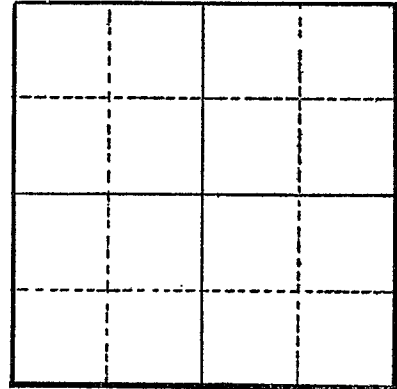

Section

Altitude at well

TYPE OF WELL: drilled Date Constructed 1948

Depth drilled 285' Depth cased 285'

CASING RECORD:

8"

FINISH:

AQUIFERS:

WATER LEVEL:

PUMPING EQUIPMENT: Type Fairbanks Morse H.P. 5
Capacity 80 G.P.M.

WELL TESTS:

Drawdown ft. after hours G.P.M.

Drawdown ft. after hours G.P.M.

USE OF WATER Irrigation Temp. °F. 19

SOURCE OF INFORMATION GR-3147

DRILLER or DIGGER O. B. Olson

ADDITIONAL DATA:

Log Water Level Measurements Chemical Analysis Aquifer Test

REMARKS: