

STATE ENGINEER
Salem, Oregon

MULT Well Record

002464

STATE WELL NO. 1/4-7K
COUNTY Multnomah
APPLICATION NO. GR-3476

OWNER: Stanley W. Roser

MAILING ADDRESS: Route 2, Box 1090

LOCATION OF WELL: Owner's No.

CITY AND STATE: Troutdale, Oregon


NW 1/4 SE 1/4 Sec. 7 T. 1 S. R. 4 E. W.M.

Bearing and distance from section or subdivision
corner S. 66°00' W.

Altitude at well

TYPE OF WELL: drilled Date Constructed 1955

Depth drilled 95' Depth cased 95'

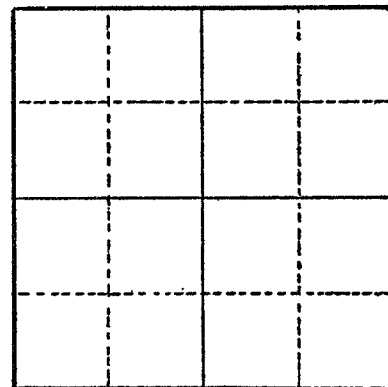

Section

CASING RECORD:

6"

FINISH:

AQUIFERS:

WATER LEVEL:

45'

PUMPING EQUIPMENT: Type Gould Deepwell turbine 2" H.P. 2
Capacity 40 G.P.M.

WELL TESTS:

Drawdown 10 ft. after hours pumping 50 G.P.M.
Drawdown ft. after hours G.P.M.

USE OF WATER Irrigation Temp. °F. 19

SOURCE OF INFORMATION GR-3210

DRILLER or DIGGER A. A. Olsen Route 1, Box 565 Gresham, Oregon

ADDITIONAL DATA:

Log Water Level Measurements Chemical Analysis Aquifer Test

REMARKS: