

STATE ENGINEER
Salem, Oregon

MULT
002470

Well Record

GR-965

STATE WELL NO. 1/4-8E(1)
COUNTY Multnomah
APPLICATION NO. GR-999

OWNER: Walter Edwin Armstrong

MAILING

ADDRESS:

LOCATION OF WELL: Owner's No.


CITY AND

STATE: Troutdale, Oregon

SW 1/4 NW 1/4 Sec. 8 T. 1 S., R. 4 E., W.M.

Bearing and distance from section or subdivision

corner 1050' E. & 1810' S. from NW cor. Sec. 8.

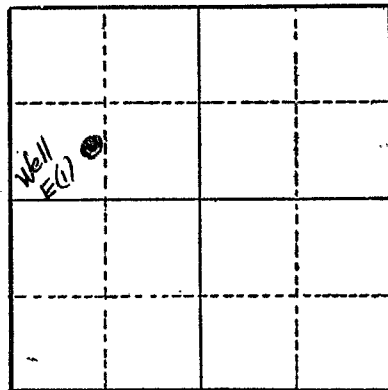

Altitude at well 455 ft.

TYPE OF WELL: Drilled Date Constructed 1951

Depth drilled 416 ft. Depth cased

Section 8

CASING RECORD:

8 inch

FINISH:

1/2 in. perforations: 110 to 114 ft.
335 to 340 ft.

355 to 363 ft.
400 to 406 ft.

AQUIFERS:

WATER LEVEL:

306 ft.

PUMPING EQUIPMENT: Type Layne & Bowler

H.P. 30

Capacity 275 G.P.M.

WELL TESTS:

Drawdown 81 ft. after 350 hours G.P.M.

Drawdown 49 ft. after 200 hours G.P.M.

USE OF WATER Irrigation Temp. °F. 19

SOURCE OF INFORMATION G.R. Record

DRILLER or DIGGER

ADDITIONAL DATA:

Log X Water Level Measurements Chemical Analysis Aquifer Test

REMARKS:

Irrigation of 30 acres.

State Well No. 1/4-8E(1)
County Multnomah
Application No. GR- 999

Owner: Walter Edwin Armstrong Owner's No.

Driller: _____ Date Drilled 1951 _____[illegible]