

STATE ENGINEER
Salem, Oregon

MULT
002544

Well Record

GR# 1490

STATE WELL NO. 1/4-17K
COUNTY Multnomah
APPLICATION NO. GR- 1102

OWNER: Mrs. Jane E. Taylor

MAILING

ADDRESS: Rt. 2, Box 652

LOCATION OF WELL: Owner's No.


CITY AND

STATE: Gresham, Oregon

NW 1/4 SE 1/4 Sec. 17 T. 1 S., R. 4 E., W.M.

Bearing and distance from section or subdivision

corner 1510' N. & 2550' W. from SE cor. Sec. 17

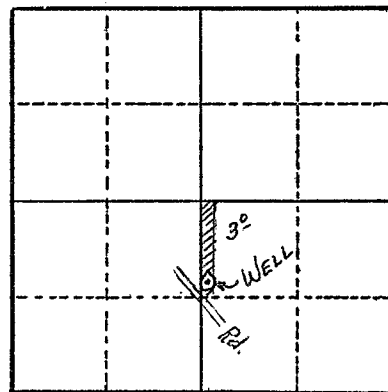

Section 17

Altitude at well 600'

TYPE OF WELL: Drilled Date Constructed 1951

Depth drilled 175' Depth cased 169'

CASING RECORD:

8"

FINISH:

Perforated

AQUIFERS:

Water in black gravel at 169'

WATER LEVEL:

138'

PUMPING EQUIPMENT: Type Pomona Little Chief turbine H.P. 5
Capacity 24 1/2 to 30 G.P.M.

WELL TESTS:

Drawdown 14 ft. after 30 hours G.P.M.

Drawdown ft. after hours G.P.M.

USE OF WATER Irrigation Temp. °F., 19

SOURCE OF INFORMATION GR Record

DRILLER or DIGGER

ADDITIONAL DATA:

Log Water Level Measurements Chemical Analysis Aquifer Test

REMARKS:

Log: Yellow Clay 0 to 77 ft.
Cement gravel 77 to 150 ft.
Black gravel 150 to 175 ft.

Irrigation of 3 acres.