

STATE ENGINEER  
Salem, Oregon

MULT.  
002548

# Well Record


STATE WELL NO. 1/4-18Q(1)  
COUNTY Multnomah  
APPLICATION NO. GR-95

OWNER: Lloyd D. Corlies  
MAILING ADDRESS: Rt. 2, Box 795

LOCATION OF WELL: Owner's No. 1  
CITY AND STATE: Gresham, Oregon

SW 1/4 SE 1/4 Sec. 18 T. 1 N. S. R. 4 W. E. W.M.

Bearing and distance from section or subdivision corner 1650' W. & 990' N. from SE cor. Sec. 18

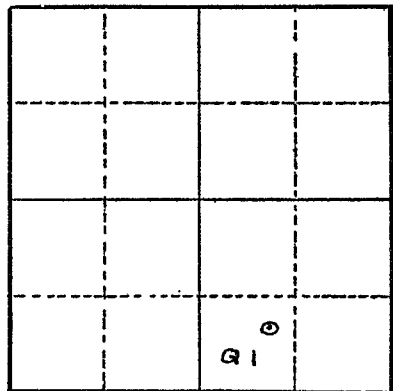

Section 18

Altitude at well

TYPE OF WELL: drilled Date Constructed 1955

Depth drilled 234 ft. Depth cased 234 ft.

CASING RECORD: 8 inch casing set from 0 to 158 ft.  
6 inch casing set from 158 to 230 ft.

FINISH: 2" x 3/16" perforations (4 per foot) set from 158 to 230 ft.

AQUIFERS: Sand & gravel from 75 to 234 ft. (most water at 150 to 155 ft.)

WATER LEVEL: 120 ft. below land surface, Nov. 1955

PUMPING EQUIPMENT: Type Peerless Deep Well Turbine H.P. 20  
Capacity 150 G.P.M.

WELL TESTS:  
Drawdown 180 ft. after 130 hours G.P.M.  
Drawdown 200 ft. after 140 hours G.P.M.

USE OF WATER irrigation 30 acres Temp. °F., 19

SOURCE OF INFORMATION Registration Statement GR-95

DRILLER or DIGGER

ADDITIONAL DATA:  
Log  Water Level Measurements  Chemical Analysis  Aquifer Test

REMARKS:

