

STATE ENGINEER  
Salem, Oregon


MULT  
2726

# Well Record

STATE WELL NO 1/1-3D  
COUNTY MULTNOMAH  
APPLICATION NO. GR-2950

OWNER: Pacific First Federal Savings & Loan Assn  
c/o Norris, Baggs & Simpson, Agents  
LOCATION OF WELL: Owner's No. \_\_\_\_\_  
MAILING ADDRESS: 711 S.W. Alder St  
CITY AND STATE: Portland, Oregon

NW 1/4 NW 1/4 Sec. 3 T. 1 S., R. 1 E., W.M.  
Bearing and distance from section or subdivision  
corner 6' N & 6' E of the SE cor of Block 180.

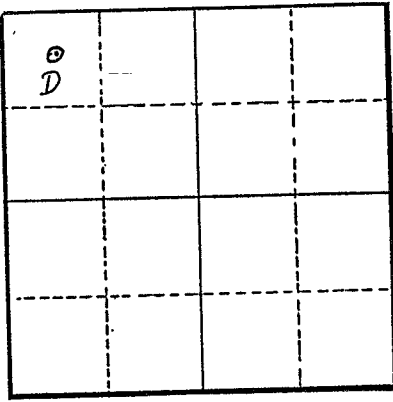

Altitude at well \_\_\_\_\_  
TYPE OF WELL: Drilled Date Constructed 1955  
Depth drilled 368' Depth cased 264'

CASING RECORD:  
14-3/8"

FINISH:  
16 rows

AQUIFERS:

WATER LEVEL:  
230'

PUMPING EQUIPMENT: Type Worthington Corp., turbine type H.P. 25  
Capacity 400 G.P.M.

WELL TESTS:  
Drawdown 140 ft. after \_\_\_\_\_ hours 700 G.P.M.  
Drawdown 96 ft. after \_\_\_\_\_ hours 500 G.P.M.

USE OF WATER Air-conditioning Temp. \_\_\_\_\_ °F. \_\_\_\_\_, 19  
SOURCE OF INFORMATION GR-3932

DRILLER or DIGGER \_\_\_\_\_  
ADDITIONAL DATA:  
Log  Water Level Measurements \_\_\_\_\_ Chemical Analysis \_\_\_\_\_ Aquifer Test \_\_\_\_\_

REMARKS:

STATE ENGINEER  
Salem, Oregon

State Well No. 1/1-3D  
County MULTNOMAH  
Application No. GR-2950

## Well Log

Owner: Pacific First Federal Savings & Loan Asso. Owner's No. \_\_\_\_\_  
c/o Norris, Baggs & Simpson, Agents  
Driller: \_\_\_\_\_ Date Drilled 1955

| CHARACTER OF MATERIAL                                | (Feet below land surface) |     | Thickness (feet) |
|--|---------------------------|-----|------------------|
|  | From                      | To  |                  |
| Topsoil & fill                                       | Sidewalk                  | 10' | 10               |
| Brown packed sand                                    | 10                        | 36  | 26               |
| Cemented gravel                                      | 36                        | 62  | 26               |
| Sand & gravel, water                                 | 62                        | 83  | 21               |
| Cemented gravel                                      | 83                        | 101 | 18               |
| Brown sandy clay                                     | 101                       | 113 | 12               |
| Sand & gravel, blue clay binder                      | 113                       | 126 | 13               |
| Sand & gravel, blue clay binder (some water)         | 126                       | 140 | 14               |
| Cemented gravel                                      | 140                       | 155 |                  |
| Sand and gravel - blue clay binder (possible water)  | 155                       | 165 | 10               |
| Sand & gravel - tight blue claybinder                | 165                       | 230 | 65               |
| Loose gravel and sand - good water bearing formation | 230                       | 237 | 7                |
| Blue clay - scattered gravel                         | 237                       | 267 | 30               |
| Brown clay   | 267                       | 300 | 33               |
| Hard green shale ledge                               | 300                       | 302 | 2                |
| Brown clay scattered green shale ledges              | 302                       | 330 | 28               |
| Hard brown shale                                     | 330                       | 333 | 3                |
| Brown clay   | 333                       | 346 | 13               |
| Brown & grey sandstone                               | 346                       | 352 | 6                |
| Brown clay - scattered scab basalt                   | 352                       | 367 | 15               |
| Grey basalt  | 367                       | 368 | 1                |
|  |                           |     |                  |
|  |                           |     |                  |