

STATE ENGINEER  
Salem, Oregon

# Well Record

STATE WELL NO. 1/1-2E  
COUNTY MULTNOMAH  
APPLICATION NO. GR-3379

**MULT**  
2727

OWNER: Arden Farms Co.


MAILING ADDRESS: 617 SE Main St.

LOCATION OF WELL: Owner's No.

CITY AND STATE: Portland, Oregon

SW 1/4 NW 1/4 Sec. 2 T. 1 S., R. 1 W., W.M.

Bearing and distance from section or subdivision corner 120' W of NE corner of block 134  
600' E & 750' N from W corner Section 2

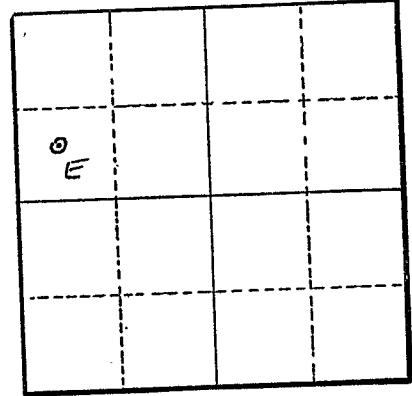

Section 2

Altitude at well

TYPE OF WELL: Drilled Date Constructed 1944

Depth drilled 307' Depth cased

CASING RECORD:

14-inch

FINISH:

NA

45' to 50'  
168' to 175'  
285' to 295'

AQUIFERS:

WATER LEVEL:

62'

PUMPING EQUIPMENT: Type Deming Deep Well Turbine Pump H.P. 75  
Capacity 1200 G.P.M.

WELL TESTS:  
Drawdown 22 ft. after 1000 hours G.P.M.  
Drawdown 27 ft. after 1200 hours G.P.M.

USE OF WATER Manufacturing Temp. °F. 19

SOURCE OF INFORMATION GR-3852

DRILLER or DIGGER R. J. Strasser

ADDITIONAL DATA:  
Log  Water Level Measurements Chemical Analysis Aquifer Test

REMARKS: