

MULT 2732  
OBSERVATION WELL  
Well Record

STATE ENGINEER  
Salem, Oregon

MULT  
2732

STATE WELL NO. 1/1-3D(6)  
COUNTY Multnomah  
APPLICATION NO.

OWNER: Pacific Service Bldg. MAILING ADDRESS:

LOCATION OF WELL: Owner's No. CITY AND STATE:

NW 1/4 NW 1/4 Sec. 6 T. 1 N S, R. 1 E W, W.M.


Bearing and distance from section or subdivision corner

Altitude at well

TYPE OF WELL: drilled Date Constructed 1958

Depth drilled 765 Depth cased

CASING RECORD: 16 inch casing set to 386 ft. open end

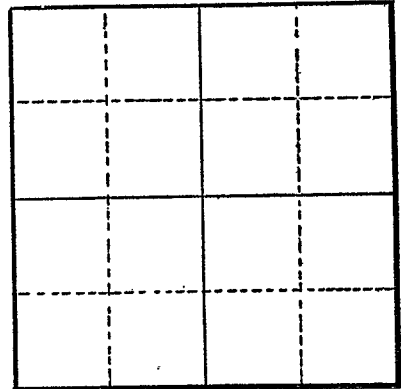

Section 3

FINISH: none - open end

AQUIFERS: Basalt from 386 to 765 ft. Strongest flow at 403 ft.

WATER LEVEL: 53 ft. below land surface - 1958

PUMPING EQUIPMENT: Type H.P.  
Capacity 750 G.P.M.

WELL TESTS:  
Drawdown 206 ft. after ? hours pumping 750 G.P.M.  
Drawdown ft. after hours G.P.M.

USE OF WATER Industrial - air cond. Temp. 59 1/2 °F. November 16, 19 59  
SOURCE OF INFORMATION R. J. Strasser Co.

DRILLER or DIGGER

ADDITIONAL DATA:

Log Water Level Measurements Chemical Analysis Aquifer Test

REMARKS: Hardness 333 ppm, chloride 376 ppm

