

STATE ENGINEER
Salem, Oregon

MULT Well Record

STATE WELL NO. 1/1-6D(2)
COUNTY Multnomah
APPLICATION NO. GR-228

2758

OWNER: Mt. Calvary Cemetery

MAILING ADDRESS: 2053 S.W. 6th Ave. P 10+3

LOCATION OF WELL: Owner's No. 2

CITY AND STATE: Portland, Oregon

NW 1/4 NW 1/4 Sec. 6 T. 1 S. R. 1 W, W.M.

Bearing and distance from section or subdivision corner

D 20			

Altitude at well 970 ft. Interpolated

TYPE OF WELL: drilled Date Constructed 8/13/54

Depth drilled 896 ft. Depth cased 96 ft.

Section 6

CASING RECORD: 16 inch I.D. casing set from 0 to 96 ft.

FINISH: Liner perforated 10 inches from 0 to 520 ft.

AQUIFERS: Basalt from 92 to 896 ft.

WATER LEVEL: 423 ft. below land surface Sept. 1954

PUMPING EQUIPMENT: Type Layne and Bowler H.P. 75
Capacity 275 G.P.M.

WELL TESTS:
Drawdown 25 ft. after hours 275 G.P.M.
Drawdown ft. after hours G.P.M.

USE OF WATER irrigation 60 acres Temp. °F., 19

SOURCE OF INFORMATION Registration Statement

DRILLER or DIGGER

ADDITIONAL DATA:

Log Water Level Measurements Chemical Analysis Aquifer Test

REMARKS:

STATE ENGINEER
Salem, Oregon

MULT
2758

Well Record

STATE WELL NO. 1/1-6D(1)
COUNTY Multnomah
APPLICATION NO.

Pg 2 of 3

OWNER: Mt. Calvary Cemetery Assoc. MAILING ADDRESS:

LOCATION OF WELL: Owner's No. CITY AND STATE:

NW 1/4 NW 1/4 Sec. 6 T. 1 S., R. 1 W., W.M.


Bearing and distance from section or subdivision corner

Altitude at well 1025 ft.

TYPE OF WELL: drilled Date Constructed

Depth drilled 896 ft. Depth cased 520 ft.

CASING RECORD: 16-10 inch

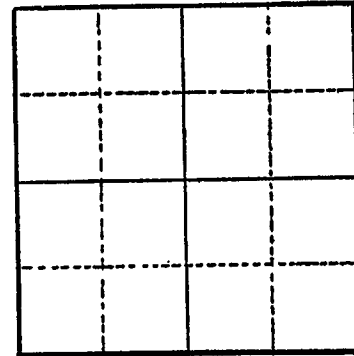

Section

FINISH:

AQUIFERS: Basalt from 829 to 838 ft.

WATER LEVEL: 423 ft. below land surface

PUMPING EQUIPMENT: Type H.P. Capacity G.P.M.

WELL TESTS: Drawdown ft. after hours G.P.M. Drawdown ft. after hours G.P.M.

USE OF WATER irrigation Temp. °F. 19

SOURCE OF INFORMATION USGS

DRILLER or DIGGER

ADDITIONAL DATA: Log Water Level Measurements Chemical Analysis Aquifer Test

REMARKS: Penetrated 92 ft. of clay and 804 ft. of basalt; pumped 280 gpm with 62 ft. of drawdown.

STATE ENGINEER
Salem, Oregon

mult
- 2758

State Well No. 1/1-6D(1)
County Multnomah
Application No. GR-228

Well Log

P 3.43

Owner: Mt. Calvary Cemetery Owner's No. 2

Driller: Date Drilled Aug. 13, 1954

CHARACTER OF MATERIAL	(Feet below 'and surface)		Thickness (feet)
	From	To	
Clay, redish brown	0	77	77
Clay, dark red	77	92	15
Rock, gray	92	101	9
Rock, broken	101	144	45
Rock, brown and broken	144	160	16
Rock, hard gray	160	165	5
Rock, broken gray	165	185	20
Rock, red lava (contact WSB)	185	202	17
Rock, black	202	368	166
Rock, with clay streaks	368	400	32
Rock, dark gray	400	430	30
Rock, hard black	430	489	59
Rock, gray	489	498	9
Rock, brown	498	521	23
Rock, hard black	521	531	10
Rock, gray (not too hard)	531	598	67
Rock, lava	598	605	7
Rock, hard black	605	660	55
Basalt, broken	660	690	30
Rock, black hard	690	838	178
Rock, lava (contact WSB)	838	846	8
Rock, black	846	896	50