

STATE ENGINEER
Salem, Oregon

MULT Well Record

STATE WELL NO. 1/1-8M(1)
COUNTY Multnomah
APPLICATION NO. Gr-249

2768

OWNER: John H. Crawford


MAILING ADDRESS: 4330 S.W. Patton Road

LOCATION OF WELL: Owner's No.

CITY AND STATE: Portland, Oregon

NW 1/4 SW 1/4 Sec. 8 T. 1 S., R. 1 W., W.M.

Bearing and distance from section or subdivision corner S. 89° 59' E. 330 ft. & N. 0° 03' 2410 ft. from SW cor. Sec. 8

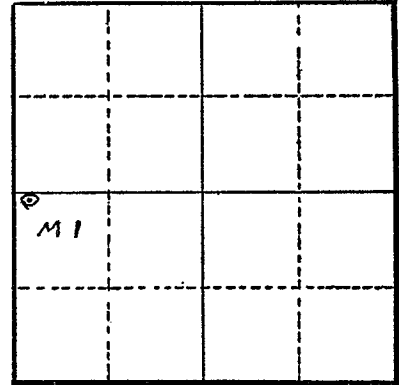

Section 8

Altitude at well 550 ft.

TYPE OF WELL: drilled Date Constructed 1928

Depth drilled 565 ft. Depth cased

CASING RECORD: 8 inch

FINISH:

AQUIFERS:

WATER LEVEL: unknown

PUMPING EQUIPMENT: Type Bingham pump H.P. 40
Capacity 150 G.P.M.

WELL TESTS:

Drawdown ft. after hours G.P.M.
Drawdown ft. after hours G.P.M.

USE OF WATER irrigation 2.5 acres Temp. °F., 19

SOURCE OF INFORMATION Ground Water Registration Record

DRILLER or DIGGER

ADDITIONAL DATA:

Log Water Level Measurements Chemical Analysis Aquifer Test

REMARKS: