

STATE ENGINEER
Salem, Oregon

MULT
2772

Well Record

STATE WELL NO. 1/1-11H1
COUNTY MULTNOMAH
APPLICATION NO.

OWNER: Libby, McNeill, & Libby


MAILING ADDRESS:

LOCATION OF WELL: Owner's No.

CITY AND STATE:

1/4 1/4 Sec. T. N. E. S., R. W., W.M.

Bearing and distance from section or subdivision corner

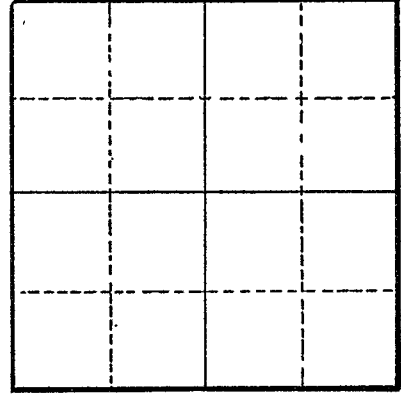

Section

Altitude at well 65

TYPE OF WELL: Drilled Date Constructed

Depth drilled 330 Depth cased 330

CASING RECORD:

12-10 inch

FINISH:

AQUIFERS:

Gravel, Troutdale formation, from 215 to 240
Sand, Gravel, Troutdale Formation, from 282 to 330

WATER LEVEL:

20.5 feet below land surface, 1929

PUMPING EQUIPMENT: Type

Turbine

H.P.

Capacity G.P.M.

WELL TESTS:

Drawdown ft. after hours G.P.M.

Drawdown ft. after hours G.P.M.

USE OF WATER

Industrial

Temp. °F.

19

SOURCE OF INFORMATION USGS

DRILLER or DIGGER

ADDITIONAL DATA:

Log X Water Level Measurements Chemical Analysis X Aquifer Test

REMARKS:

Pumped 800 gpm, drawdown 50 ft.
Perforated 215-240, 282-297, and 301-330 ft.

