

STATE ENGINEER
Salem, Oregon

MULT Well Record
2776

STATE WELL NO. 1/1-10P(1)
COUNTY Multnomah
APPLICATION NO.

OWNER: J. D. Kroeker & Assoc.


MAILING ADDRESS:

LOCATION OF WELL: Owner's No.

CITY AND STATE:

SE 1/4 SW 1/4 Sec. 10 T. 1 S., R. 1 E. W.M.

Bearing and distance from section or subdivision corner

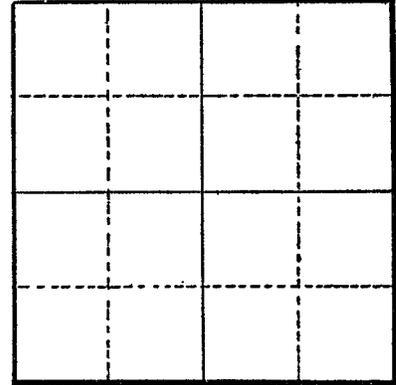

Section 10

Altitude at well 210 ft.

TYPE OF WELL: dr. Date Constructed 1954

Depth drilled 486 ft. Depth cased 99 ft.

CASING RECORD: 8 inch 0 to 99 ft.

FINISH:

AQUIFERS: basalt

WATER LEVEL:

PUMPING EQUIPMENT: Type H.P.
Capacity G.P.M.

WELL TESTS:
Drawdown 37 ft. after 45 hours G.P.M.
Drawdown 80 ft. after 90 hours G.P.M.

USE OF WATER industrial Temp. °F., 19

SOURCE OF INFORMATION GR Record

DRILLER or DIGGER

ADDITIONAL DATA:
Log Water Level Measurements Chemical Analysis Aquifer Test

REMARKS:

