

STATE ENGINEER
Salem, Oregon

MULT

Well Record

STATE WELL NO. 1/1-11 D
COUNTY MULTNOMAH
APPLICATION NO. GR-1853

2781

OWNER: Dairy Cooperative Association


MAILING ADDRESS: 1313 E 12th Ave

LOCATION OF WELL: Owner's No.

CITY AND STATE: Portland, Oregon

NW 1/4 NW 1/4 Sec. 11 T. 1 S., R. 1 E., W.M.

Bearing and distance from section or subdivision corner

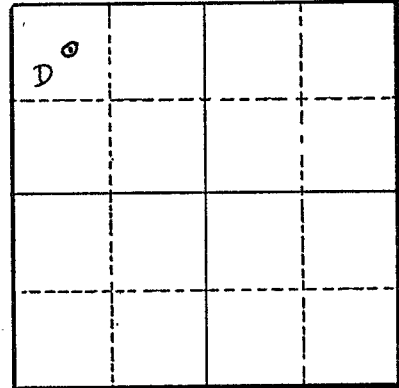

Section 11

Altitude at well

TYPE OF WELL: Drilled Date Constructed 1946

Depth drilled 490' Depth cased 450'

CASING RECORD:

16-inch

FINISH:

Casing perforated

AQUIFERS:

WATER LEVEL:

PUMPING EQUIPMENT: Type Pomona Turbin H.P. 60
Capacity 750 G.P.M.

WELL TESTS:

Drawdown ft. after hours 750 G.P.M.
Drawdown ft. after hours G.P.M.

USE OF WATER Manufacturing Temp. °F., 19

SOURCE OF INFORMATION GR-3986

DRILLER or DIGGER

ADDITIONAL DATA:

Log X Water Level Measurements Chemical Analysis Aquifer Test

REMARKS:

STATE ENGINEER
Salem, Oregon

State Well No. 1/1-11 D
County Multnomah
Application No. GR-1853

Well Log

Owner: Dairy Cooperative Association Owner's No. _____

Driller: _____ Date Drilled 1946

CHARACTER OF MATERIAL	(Feet below land surface)		Thickness (feet)
	From	To	
Surface	0	12	12
Loose Dry gravel	12	27	15
Gravel and boulders	27	42	15
Cemented gravel	42	118	76
Fine sand and water	118	121	3
Cemented gravel	121	193	72
Sand with water	193	217	24
Loose gravel	217	219	2
Cemented gravel	219	257	38
Clay and fine sand	257	262	5
Blue Clay	262	312	50
Brown clay	312	315	3
Sand	315	323	8
Green soap stone	323	330	7
Dry sand	330	333	3
Blue clay	333	335	2
Brown clay	335	339	4
Sand	339	378	39
Brown clay	378	390	12
Brown clay and gravel	390	395	5
Sandy clay	395	409	14
Grey sand	409	414	5
Gravel - sand and water	414	422	8
Shale	422	489	67

