

STATE ENGINEER
Salem, Oregon

MULT
2797

Well Record

STATE WELL NO. 1/1-18F
COUNTY Multnomah
APPLICATION NO. GR-3120

OWNER: Lena H. Gill


MAILING ADDRESS: 5439 SW Shattuck Road

LOCATION OF WELL: Owner's No.

CITY AND STATE: Portland, Oregon

SE 1/4 NW 1/4 Sec. 18 T. 1 N. S. R. 1 E. W.M.

Bearing and distance from section or subdivision corner 1985' E. and 450' N.

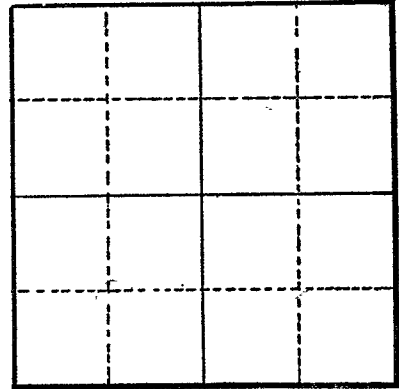

Section

Altitude at well

TYPE OF WELL: Drilled Date Constructed 1928

Depth drilled 500' Depth cased 500'

CASING RECORD:

5"

FINISH:

AQUIFERS:

WATER LEVEL:

PUMPING EQUIPMENT: Type General Electric H.P. 3
Capacity 33 G.P.M.

WELL TESTS:

Drawdown ft. after hours pumping 33 G.P.M.
Drawdown ft. after hours G.P.M.

USE OF WATER Irrigation Temp. °F., 19

SOURCE OF INFORMATION GR-2927

DRILLER or DIGGER Strauser

ADDITIONAL DATA:

Log Water Level Measurements Chemical Analysis Aquifer Test

REMARKS: