

STATE ENGINEER
Salem, Oregon

MULTI Well Record

STATE WELL NO. 1/1-18L
COUNTY Multnomah
APPLICATION NO. GR-4026

OWNER: Vivian A. Lewis

2798


MAILING ADDRESS: 6014 S.W. Shattuck Rd.

LOCATION OF WELL: Owner's No. _____

CITY AND STATE: Portland, Oregon

NE $\frac{1}{4}$ SW $\frac{1}{4}$ Sec. 18 T. 1 S., R. 1 E., W.M.

Bearing and distance from section or subdivision
corner 560' W. & 25' N. of SE Cor. of NE $\frac{1}{4}$ SW $\frac{1}{4}$

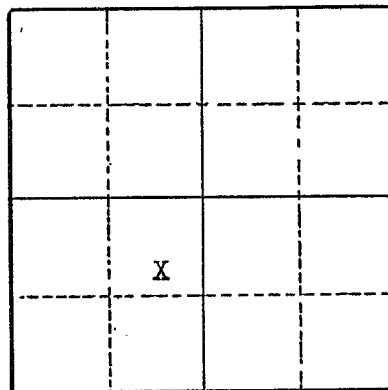

Section 18

Altitude at well _____

TYPE OF WELL: Drilled Date Constructed 1939

Depth drilled 311 ft. Depth cased 240 ft.

CASING RECORD:

4 inch drop to pump. 6 inch casing set to 240 feet

FINISH:

AQUIFERS:

WATER LEVEL:

310 feet below surface

PUMPING EQUIPMENT: Type Crane H.P. _____

Capacity _____ G.P.M.

WELL TESTS:

Drawdown 0 ft. after _____ hours 100 G.P.M.

Drawdown _____ ft. after _____ hours _____ G.P.M.

USE OF WATER Irrigation Temp. _____ °F., 19 _____

SOURCE OF INFORMATION Well Registration Statement Cert. # GR-3625

DRILLER or DIGGER Ben Karsh

ADDITIONAL DATA:

Log _____ Water Level Measurements _____ Chemical Analysis _____ Aquifer Test _____

REMARKS: