

STATE ENGINEER  
Salem, Oregon

MULT  
2800

Well Record


STATE WELL NO. 1/1-18N  
COUNTY Multnomah  
APPLICATION NO. GR-2582

OWNER: H. C. Cadonau of Alpenrose Farms MAILING ADDRESS: 6149 S.W. Shattuck Rd.

LOCATION OF WELL: Owner's No. CITY AND STATE: Portland, Oregon

SW 1/4 SW 1/4 Sec. 18 T. 1 S., R. 1 E., W.M.

Bearing and distance from section or subdivision corner

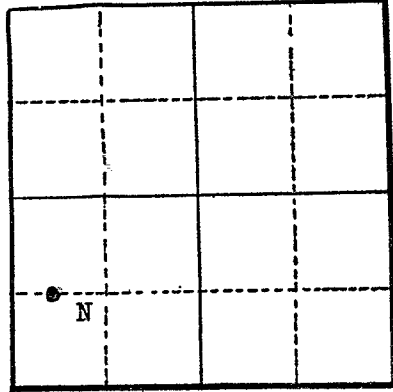

Section 18

Altitude at well 30'

TYPE OF WELL: Drilled Date Constructed 1927

Depth drilled 420' Depth cased 420'

CASING RECORD:

8-inch

FINISH:

AQUIFERS:

WATER LEVEL:

PUMPING EQUIPMENT: Type Pomona Turbine H.P. 25  
Capacity 140 G.P.M.

WELL TESTS:  
Drawdown 63 ft. after 140 hours G.P.M.  
Drawdown ft. after hours G.P.M.

USE OF WATER Milk Pland & Irrigation Temp. °F. 19

SOURCE OF INFORMATION GR-3994

DRILLER or DIGGER

ADDITIONAL DATA:  
Log NA Water Level Measurements Chemical Analysis Aquifer Test

REMARKS: