

STATE ENGINEER
Salem, Oregon

MULT
2807

Well Record


STATE WELL NO. 1/1-22B
COUNTY MULTNOMAH
APPLICATION NO. GR-1924

OWNER: E. S. Bells, Man. Dir. HUNTING
RUBBER MILLS

MAILING ADDRESS: P. O. Box 570
CITY AND STATE: Portland, Oregon

LOCATION OF WELL: Owner's No. _____
NW 1/4 NE 1/4 Sec. 22 T. 1 S., R. 1 E., W.M.

Bearing and distance from section or subdivision
corner 2500' W & 1150' S from NE cor Sec 22

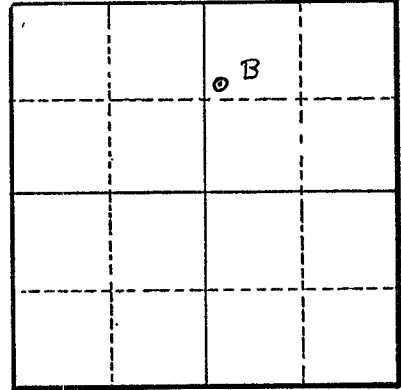

Section 22

Altitude at well _____

TYPE OF WELL: Drilled Date Constructed 1943

Depth drilled 235' Depth cased 230'

CASING RECORD: 10-inch

FINISH:

AQUIFERS:

WATER LEVEL:

223'

PUMPING EQUIPMENT: Type Deming Deep Well Pump H.P. 10
Capacity 150 G.P.M.

WELL TESTS:
Drawdown 80 ft. after _____ hours 150 G.P.M.
Drawdown _____ ft. after _____ hours _____ G.P.M.

USE OF WATER Cooling & Pressurizing Temp. _____ °F. _____, 19

SOURCE OF INFORMATION GR3937
DRILLER or DIGGER O. B. Olsen

ADDITIONAL DATA:
Log Water Level Measurements _____ Chemical Analysis _____ Aquifer Test _____

REMARKS:

