

STATE ENGINEER
Salem, Oregon

MULT
2839

Well Record

STATE WELL NO. 1/2-1G
COUNTY Multnomah
APPLICATION NO. GR-1121

GR- 1081

OWNER: Oregon Asphaltic Paving Company


MAILING ADDRESS: 0441 SW Porter St.

LOCATION OF WELL: Owner's No.

CITY AND STATE: Portland 1, Oregon

SW 1/4 NE 1/4 Sec. 1 T. 1 S., R. 2 W., W.M.

Bearing and distance from section or subdivision corner N44°13'E. 2471.04' to NE cor. of Sec. 1.

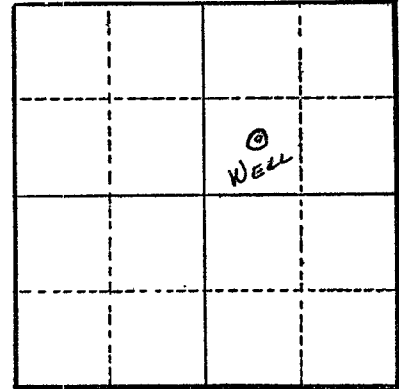

Section 1

Altitude at well 247 ft.

TYPE OF WELL: Drilled Date Constructed 1952

Depth drilled 287 ft. Depth cased 287 ft.

CASING RECORD:

- 12 in. from 0 to 224 ft.
- 10 in. from 220 to 287 ft.

FINISH: 24 perforations per ft. - 3/8" x 1/4" from 272 to 287 ft.
 24 perforations per ft. - 3/8" x 1/4" from 80 to 89 ft.
 " " " " " " " " 104 to 112 ft.
 " " " " " " " " 247 to 249 ft.

AQUIFERS: Gravel with 50 to 75 GPM from 80 to 89 ft.
 Gravel with 100 to 150 GPM from 103 to 112 ft.
 Gravel with small amount of water. --- Water gravel (raised S.L. to 65 ft.)

WATER LEVEL: 65 ft. from 272 to 287 ft.

PUMPING EQUIPMENT: Type Western LAND ROLLER TURBINE H.P. 40
Capacity 750 G.P.M.

WELL TESTS:
 Drawdown 4 ft. after _____ hours 450 G.P.M.
 Drawdown 7 ft. after _____ hours 740 G.P.M.

USE OF WATER Washing gravel (Industrial) Temp. _____ °F., 19

SOURCE OF INFORMATION G. R. Record

DRILLER or DIGGER Haakon I. Bottner

ADDITIONAL DATA:

Log Water Level Measurements _____ Chemical Analysis _____ Aquifer Test _____

REMARKS:

*North 44 deg
 13 min East
 2471.04 feet
 from NE
 corner, Section 1*

