

STATE ENGINEER  
Salem, Oregon

**MULT** Well Record  
2843

STATE WELL NO. 1/2-2L(2)  
COUNTY Multnomah  
APPLICATION NO. GR-3062

OWNER: Roy W. Oliver


MAILING ADDRESS: 13050 S. E. Mill St.

LOCATION OF WELL: Owner's No.

CITY AND STATE: Portland, Oregon

NE 1/4 SW 1/4 Sec. 2 T. 1 N. S. R. 2 E. W., W.M.

Bearing and distance from section or subdivision corner S. 78° 00' E. W 1/4 cor. Sec. 2

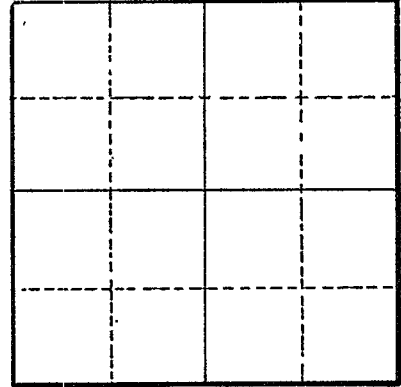

Section 2

Altitude at well

TYPE OF WELL: Drilled Date Constructed 1946

Depth drilled 158 Depth cased

CASING RECORD:

Unknown

FINISH:

Unknown

AQUIFERS:

Unknown

WATER LEVEL:

96

PUMPING EQUIPMENT: Type Peerless Electric H.P. 5

Capacity 30 G.P.M.

WELL TESTS:

Drawdown ft. after hours G.P.M.

Drawdown ft. after hours G.P.M.

USE OF WATER Irrigation Temp. °F. 19

SOURCE OF INFORMATION GR-3062

DRILLER or DIGGER

ADDITIONAL DATA:

Log Water Level Measurements Chemical Analysis Aquifer Test

REMARKS: