

STATE ENGINEER
Salem, Oregon

MULT
2847

Well Record

STATE WELL NO. 1/2-3P
COUNTY MULTNOMAH
APPLICATION NO. GR-2581

OWNER: Rosa M. Condon & William Craswell


MAILING ADDRESS: 10717 E Division St.

LOCATION OF WELL: Owner's No.

CITY AND STATE: Portland, Oregon

SE 1/4 ~~SW~~ 1/4 Sec. 3 T. 1 S., R. 2 E., W.M.

Bearing and distance from section or subdivision corner 2700' E & 850' N from SW corner Sec 3

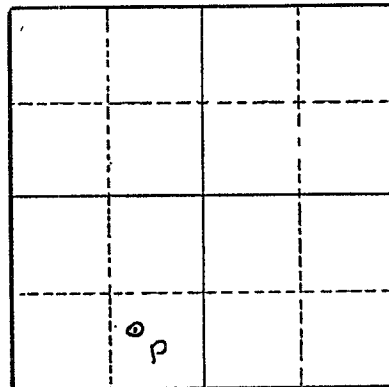

Altitude at well

TYPE OF WELL: Drilled Date Constructed 1931

Depth drilled 130' Depth cased

Section 3

CASING RECORD:

10-inch

FINISH:

AQUIFERS:

WATER LEVEL:

PUMPING EQUIPMENT: Type Fairbanks Morris Turbine H.P. 7
Capacity 300 G.P.M.

WELL TESTS:
Drawdown 5 ft. after 300 hours G.P.M.
Drawdown ft. after hours G.P.M.

USE OF WATER Industrial Temp. °F., 19
SOURCE OF INFORMATION GR-3895

DRILLER or DIGGER

ADDITIONAL DATA:

Log NA Water Level Measurements Chemical Analysis Aquifer Test

REMARKS: