

STATE ENGINEER  
Salem, Oregon

MULT  
2901


# Well Record

STATE WELL NO. 1/2 - 22N  
COUNTY MULTNOMAH  
APPLICATION NO. GR-2233

OWNER: Gordon E. Morris, President of Lincoln Memorial Park, an Oregon corporation  
MAILING ADDRESS: 10500 S. E. Mt. Scott Blvd.  
CITY AND STATE: Portland, Oregon

LOCATION OF WELL: Owner's No. \_\_\_\_\_  
SW 1/4 SW 1/4 Sec. 22 T. 1 N. S., R. 2 E. W., W.M.

Bearing and distance from section or subdivision corner N. 40° 38' 45" E.

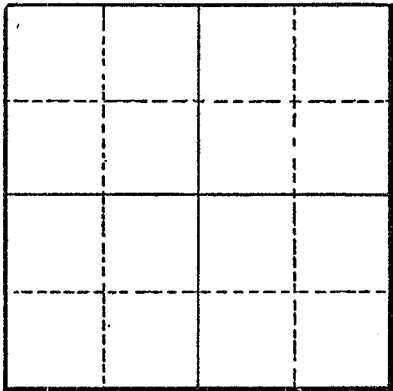

Section \_\_\_\_\_

Altitude at well \_\_\_\_\_

TYPE OF WELL: Drilled Date Constructed 1953

Depth drilled 525 Depth cased 82.5

### CASING RECORD:

12-Inch

### FINISH:

### AQUIFERS:

Rock

### WATER LEVEL:

275-Feet

PUMPING EQUIPMENT: Type Peerless Vertical Turbine H.P. 50  
Capacity 260 G.P.M.

WELL TESTS:  
Drawdown 65 ft. after \_\_\_\_\_ hours Pumping 260 G.P.M.  
Drawdown \_\_\_\_\_ ft. after \_\_\_\_\_ hours \_\_\_\_\_ G.P.M.

USE OF WATER Irrigation Temp. \_\_\_\_\_ °F. \_\_\_\_\_, 19

SOURCE OF INFORMATION GR-2137

DRILLER or DIGGER \_\_\_\_\_

ADDITIONAL DATA:  
Log  Water Level Measurements \_\_\_\_\_ Chemical Analysis \_\_\_\_\_ Aquifer Test \_\_\_\_\_

### REMARKS:

