

STATE ENGINEER
Salem, Oregon

MULT
2902

Well Record

STATE WELL NO. 1/2-22-B
COUNTY MULTNOMAH
APPLICATION NO. GR-1991

OWNER: Fred T. Heiman

MAILING ADDRESS:

LOCATION OF WELL: Owner's No.

CITY AND STATE:


Portland

NW 1/4 NE 1/4 Sec. 22 T. 1 S., R. 2 E., W.M.

Bearing and distance from section or subdivision

corner Tax Lot 2, commencing at SE corner of W

Half of NE

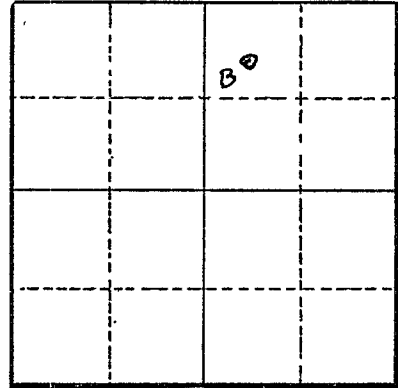

Section 22

Altitude at well

TYPE OF WELL: Drilled Date Constructed 1950

Depth drilled 170' Depth cased 170'

CASING RECORD:

12-inch

FINISH:

90'

AQUIFERS:

Top soil
Gravel

WATER LEVEL:

70'

PUMPING EQUIPMENT: Type Fairbanks Morse

H.P. 25

Capacity 280 G.P.M.

WELL TESTS:

Drawdown 100 ft. after hours 280 G.P.M.

Drawdown ft. after hours G.P.M.

USE OF WATER Irrigation Temp. °F., 19

SOURCE OF INFORMATION GR-3869

DRILLER or DIGGER

ADDITIONAL DATA:

Log Water Level Measurements Chemical Analysis Aquifer Test

REMARKS:

Top soil 5'
Gravel 15'
Depth at bottom