

STATE ENGINEER
Salem, Oregon

MULT
2916

Well Record

STATE WELL NO. 1/3-1A
COUNTY Multnomah
APPLICATION NO. GR-1765


GR- 1712

OWNER: Mountain View Nurseries, Inc. MAILING ADDRESS: Rt. 2, Box 969

LOCATION OF WELL: Owner's No. #1 CITY AND STATE: Troutdale, Oregon

NE 1/4 NE 1/4 Sec. 1 T. 1 S., R. 3 E. XX, W.M.

Bearing and distance from section or subdivision corner 547' S. & 277' W. from NE cor. Sec. 1

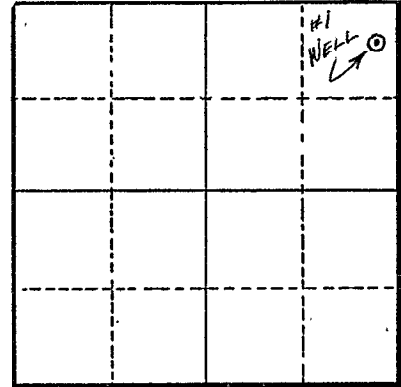

Section 1

Altitude at well 220'

TYPE OF WELL: Drilled Date Constructed 1927

Depth drilled 130' Depth cased 130'

CASING RECORD:
4"

FINISH:

AQUIFERS:

WATER LEVEL:
110'

PUMPING EQUIPMENT: Type Peerless Hilift turbine H.P. 5
Capacity 32 G.P.M.

WELL TESTS:
Drawdown ft. after hours G.P.M.
Drawdown ft. after hours G.P.M.

USE OF WATER Irrigation Temp. °F. 19

SOURCE OF INFORMATION GR Record

DRILLER or DIGGER

ADDITIONAL DATA:
Log N.A. Water Level Measurements Chemical Analysis Aquifer Test

REMARKS:

Irrigation of 6 acres.