

STATE ENGINEER
Salem, Oregon

MULT
2921

Well Record

STATE WELL NO. 1/3-1J
COUNTY Multnomah
APPLICATION NO. GR-1766

GR- 1713

OWNER: Mountain View Nurseries, Inc.


MAILING ADDRESS: Rt. 2, Box 969

LOCATION OF WELL: Owner's No. #2

CITY AND STATE: Troutdale, Oregon

NE 1/4 SE 1/4 Sec. 1 T. 1 S, R. 3 ^{XK} ^{E.} ~~XK~~, W.M.

Bearing and distance from section or subdivision
corner 3329' S. & 860' W. from NE cor. Sec. 1

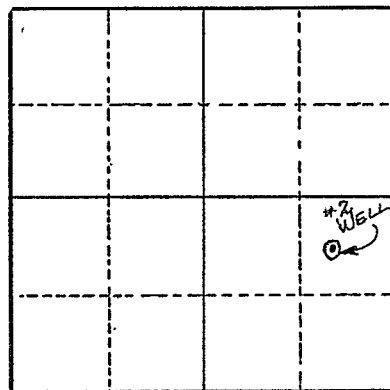

Section 1

Altitude at well 265'

TYPE OF WELL: Drilled Date Constructed 1951

Depth drilled 450' Depth cased 325'

CASING RECORD:
8"

FINISH:

AQUIFERS:

WATER LEVEL:
215'

PUMPING EQUIPMENT: Type Pacific-Beresford submersible H.P. 15
Capacity 203 G.P.M.

WELL TESTS:
Drawdown 10.4 ft. after hours 183 G.P.M.
Drawdown ft. after hours G.P.M.

USE OF WATER Irrigation Temp. °F., 19

SOURCE OF INFORMATION GR Record

DRILLER or DIGGER

ADDITIONAL DATA:
Log ^X Water Level Measurements Chemical Analysis Aquifer Test

REMARKS:

Irrigation of 40 acres.

