

STATE ENGINEER
Salem, Oregon

MULT
2928

Well Record

STATE WELL NO. 1/3 - 2D
COUNTY MULTNOMAH
APPLICATION NO. GR-2191

OWNER: Earl A. and Marian J. Keeney


MAILING ADDRESS: 3245 N.E. 73

LOCATION OF WELL: Owner's No.

CITY AND STATE: Portland, Oregon

NW 1/4 NW 1/4 Sec. 2 T. 1 N. 3 E. W., W.M.

Bearing and distance from section or subdivision corner 940' S. and 480' E.

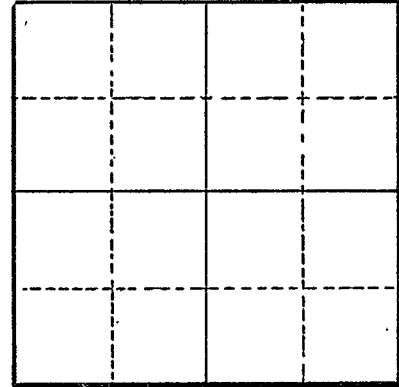

Section

Altitude at well

TYPE OF WELL: Drilled Date Constructed 1951

Depth drilled 59 Depth cased 58

CASING RECORD:

6-Inch

FINISH:

AQUIFERS:

Soil, sand and gravel

WATER LEVEL:

45-Feet

PUMPING EQUIPMENT: Type Piston type H.P. 1/2
Capacity 15 G.P.M.

WELL TESTS:

Drawdown 5 ft. after hours Pumping 20 G.P.M.
Drawdown ft. after hours G.P.M.

USE OF WATER Irrigation, Domestic & Temp. °F., 19

SOURCE OF INFORMATION Livestock GR-2096

DRILLER or DIGGER Hamblot & Galmeon Drilling Co., 5320 S. E. Woodstock, Portland, Ore

ADDITIONAL DATA:

Log Water Level Measurements Chemical Analysis Aquifer Test

REMARKS:

Soil 9 9
Sand and gravel 45 54
Bedrock or hardpan 5 59
Water under pressure