

STATE ENGINEER
Salem, Oregon

MULT
2937

Well Record

STATE WELL NO. 1/3-3
COUNTY MULTNOMAH
APPLICATION NO. GR-2823

OWNER: V. E. & Ruth Preedy


MAILING ADDRESS: Rt. 1, Box 963

LOCATION OF WELL: Owner's No.

CITY AND STATE: Gresham, Oregon

SE $\frac{1}{4}$ SW $\frac{1}{4}$ SW $\frac{1}{4}$ SE $\frac{1}{4}$ Sec. 3 T. 1 S., R. 3 W., W.M.

Bearing and distance from section or subdivision corner N. 73° 15' W.

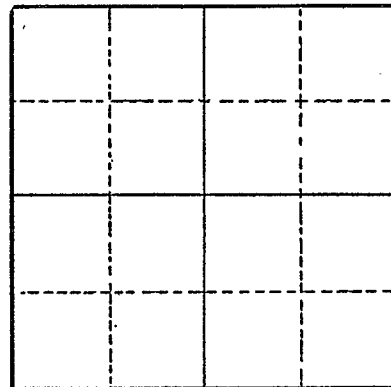

Section

Altitude at well

TYPE OF WELL: dug Date Constructed 1945

Depth drilled 23 Depth cased 23

CASING RECORD:

28-inch

FINISH:

2" perforations bottom 6-feet from 17' to 23'

AQUIFERS:

Topsoil, clay, gravel

WATER LEVEL:

15-feet

PUMPING EQUIPMENT: Type Centrifugal H.P. 3
Capacity 130 G.P.M.

WELL TESTS:

Drawdown 4 ft. after hours Pumping 130 G.P.M.
Drawdown ft. after hours G.P.M.

USE OF WATER irrigation Temp. °F., 19

SOURCE OF INFORMATION GR-2663

DRILLER or DIGGER

ADDITIONAL DATA:

Log ^X Water Level Measurements Chemical Analysis Aquifer Test

REMARKS:

Topsoil 1 1
Clay 6 7
Cement gravel 18 8 1/2
Lake bed gravel to bottom 14' 1" 23