


STATE ENGINEER
Salem, Oregon

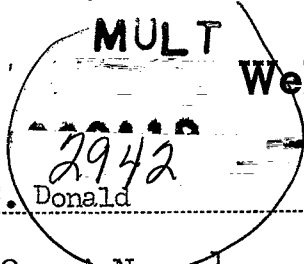

Well Record

STATE WELL NO. 1/3-3M(1)
COUNTY Multnomah
APPLICATION NO. GR-654

OWNER: Florence C. Donald


MAILING ADDRESS: 6525 S.E. Stark Ave.

LOCATION OF WELL: Owner's No. 1

CITY AND STATE: Portland, Oregon

NW 1/4 SW 1/4 Sec. 3 T. 1 N S., R. 3 E. W, W.M.

Bearing and distance from section or subdivision corner 1040 Ft. E. & 175 ft. S. from W 1/4 cor. Sec. 3

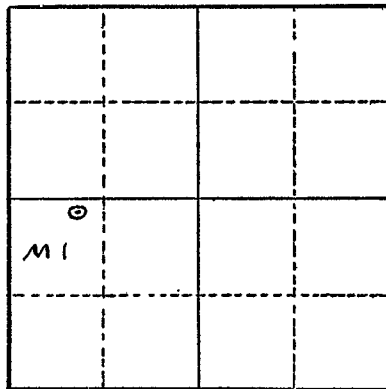

Section 3

Altitude at well 290

TYPE OF WELL: drilled Date Constructed June, 1938

Depth drilled 100 Depth cased

CASING RECORD: 8 inch

FINISH:

AQUIFERS:

WATER LEVEL: 30 ft.

PUMPING EQUIPMENT: Type Peerless Pamona H.P. 10
Capacity 200 G.P.M.

WELL TESTS:
Drawdown 5 ft. after hours 160 G.P.M.
Drawdown ft. after hours G.P.M.

USE OF WATER irrigation - 60 ac. Temp. °F., 19

SOURCE OF INFORMATION Gr-654

DRILLER or DIGGER Steinman Bros.; Portland, Oregon

ADDITIONAL DATA:
Log Water Level Measurements Chemical Analysis Aquifer Test

REMARKS:

