

STATE ENGINEER
Salem, Oregon

MULT
2949

Well Record

GR- 1746

STATE WELL NO. 1/3-4E
COUNTY Multnomah
APPLICATION NO. GR- 1805

OWNER: Joseph W. Valentine


MAILING ADDRESS: Rt. 1, Box 749B

LOCATION OF WELL: Owner's No. _____

CITY AND STATE: Gresham, Oregon

SW 1/4 NW 1/4 Sec. 4 T. 1 S. R. 3 W. W.M.

Bearing and distance from section or subdivision corner 900' E. & 150' N. from W 1/4 cor. Sec. 4

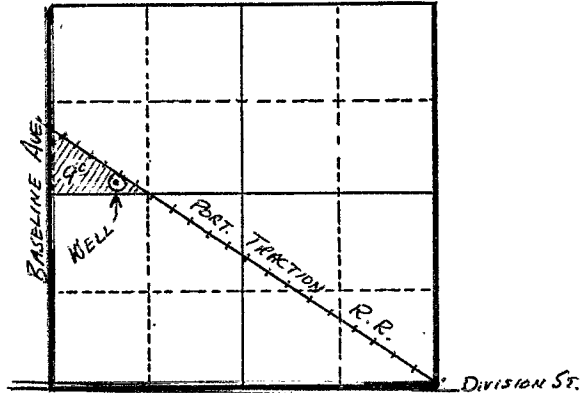

Section 4

Altitude at well 300'

TYPE OF WELL: Drilled Date Constructed 1951

Depth drilled 90' Depth cased 86'

CASING RECORD:

8"

FINISH:

AQUIFERS:

WATER LEVEL:

5'

PUMPING EQUIPMENT: Type G. E. Jet Type H.P. _____

Capacity 20 G.P.M.

WELL TESTS:

Drawdown 0 ft. after _____ hours 250 G.P.M.

Drawdown _____ ft. after _____ hours _____ G.P.M.

USE OF WATER Irrigation Temp. _____ °F. _____, 19_____

SOURCE OF INFORMATION GR Record

DRILLER or DIGGER _____

ADDITIONAL DATA:

Log _____ Water Level Measurements _____ Chemical Analysis _____ Aquifer Test _____

REMARKS:

Log:	Top soil & clay	0 to 10 ft.
	Gravel	10 to 50 ft.
	Large boulders	50 to 56 ft.
	Sand	56 to 63 ft.
	Gravel	63 to 70 ft.
	Water bearing gravel & clay deposits	70 to 86 ft.
	Open hole	86 to 90 ft.

Irrigation of 9 acres.