

STATE ENGINEER
Salem, Oregon

MULT
2950

Well Record

STATE WELL NO. 1/3-4G
COUNTY MULTNOMAH
APPLICATION NO. GR-3086

OWNER: E. P. Baltz


MAILING ADDRESS: Rt 1, Box 748

LOCATION OF WELL: Owner's No.

CITY AND STATE: Gresham, Oregon

NE 1/4 SW 1/4 Sec. 4 T. 1 S., R. 3 E., W.M.

Bearing and distance from section or subdivision corner 1440' E & 100' S from W 1/4 cor Sec 4

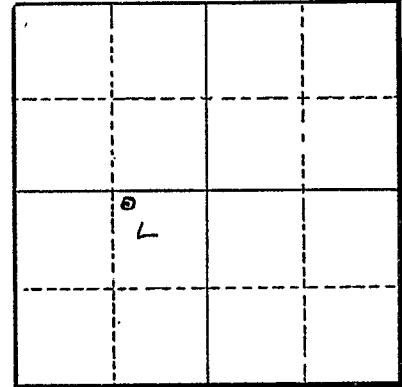

Section 4

Altitude at well

TYPE OF WELL: Drilled Date Constructed 1938

Depth drilled 67' Depth cased 60'

CASING RECORD:
6-inch

FINISH:

perforated at bottom about 5' 60' to 65'

AQUIFERS:

WATER LEVEL:

30'

PUMPING EQUIPMENT: Type Jacuzzi Jet H.P.

Capacity 35 G.P.M.

WELL TESTS:

Drawdown 20 ft. after 50 hours G.P.M.

Drawdown ft. after hours G.P.M.

USE OF WATER Irrigation Temp. °F., 19

SOURCE OF INFORMATION GR-3933

DRILLER or DIGGER Ziesing Well Driller

ADDITIONAL DATA:

Log NA Water Level Measurements Chemical Analysis Aquifer Test

REMARKS: